


LEGEND

- SP Existing sign and post
- CCTV Existing sign on CCTV column
- LC Existing lamp column and sign plate
- SP Sign and post to be removed/relocated
- SP Sign plate to be removed/relocated from sign post
- CCTV Sign plate to be removed/relocated from CCTV column
- LC Sign plate to be removed/relocated from lamp column
- LTS Proposed sign and post
- LTS Proposed sign on existing post
- LTS Proposed sign on CCTV column
- LTS Proposed sign on existing lamp column
- LC Existing lamp column
- TL Existing traffic signal
- B Existing Bollard
- IB Existing illuminated bollard
- CCTV Existing CCTV column
- Existing service cover

- NOTES**
1. Road markings, service covers and locations of existing signs are indicative.
 2. Minimum clearance to all signs to be 450mm.
 3. Sign mounting height to be 2300mm.

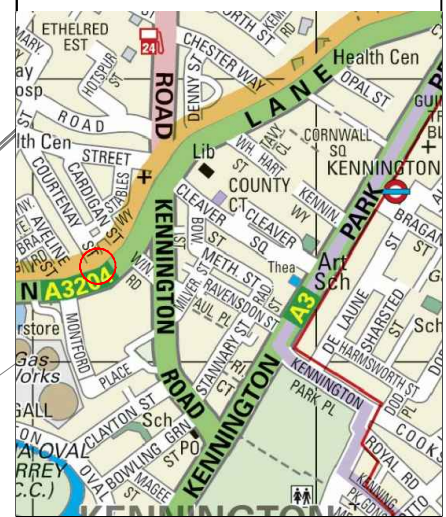

Sign:	LTS16
New ULEZ sign to be mounted on existing CCTV column.	
Sign:	LTS16
x-height:	Varies, Main sign 62.5mm
Width:	630mm
Height:	1245mm
Area:	0.78m ²
Material:	Class R3B (12899-1:2007)
For Sign details refer to drawing ULEZ-TDE-TSL-ZZ-DR-TE-23-011	

Z01	07.03.19	As Built	AJJ	CP	CAH
rev	date	details	drn	chk	app

Surface Transport

Road Space Management
 Outcomes Design Engineering

Palestra
 197 Blackfriars Road
 London
 SE1 8NJ

borough
 Lambeth

scheme
 ULEZ
 Courtenay Street / Kennington Lane
 As Built Layout

date	scale	dm	chk	app	sheet no
AUG 18	1:200 @ A3	MJ	CAH	KVT	3 OF 3
suitability	revisions				
AB	AS BUILT				Z01
drawing No	ULEZ.L6-RSM-TSL-09-DR-TE-01-3				

© Crown copyright and database rights 2019 Ordnance Survey 100035971