


Millbank

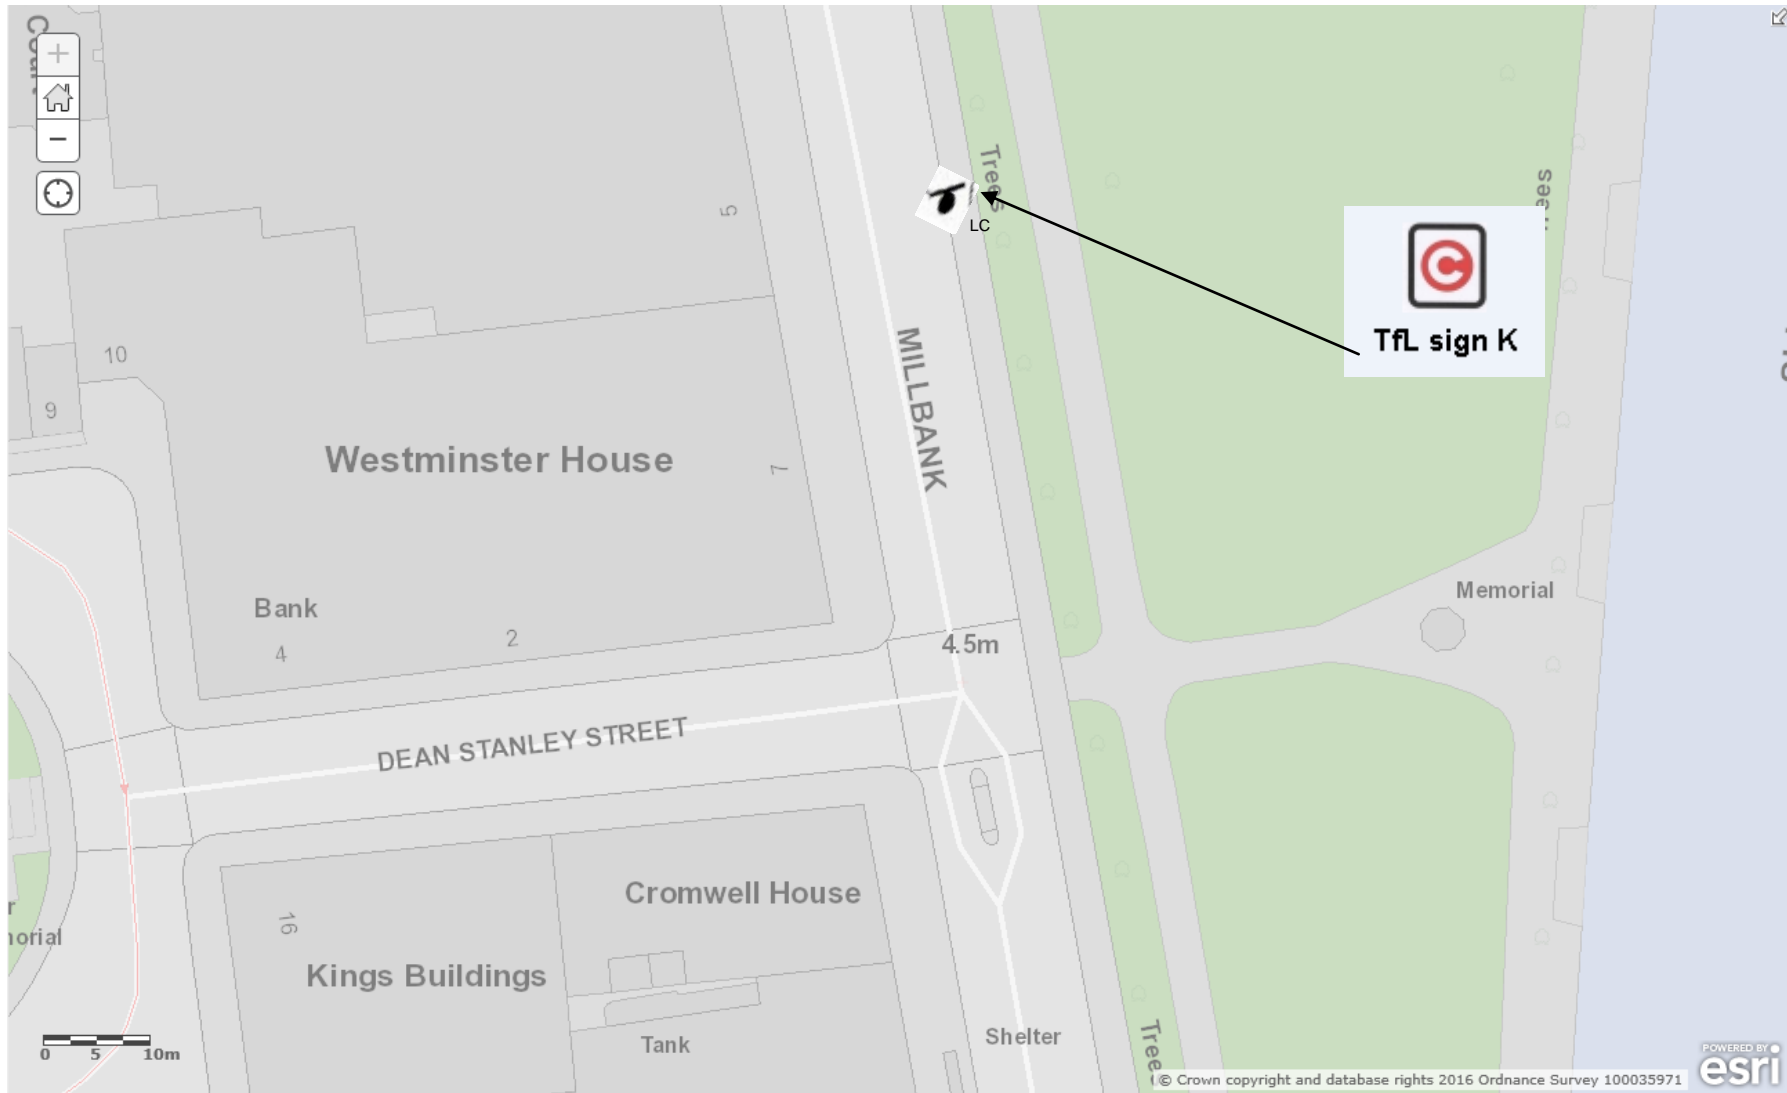

AS-BUILT

Congestion Charging Scheme

LN40002_AB_WE_081.8

Millbank just East of Dean Stanley St