


The Strand

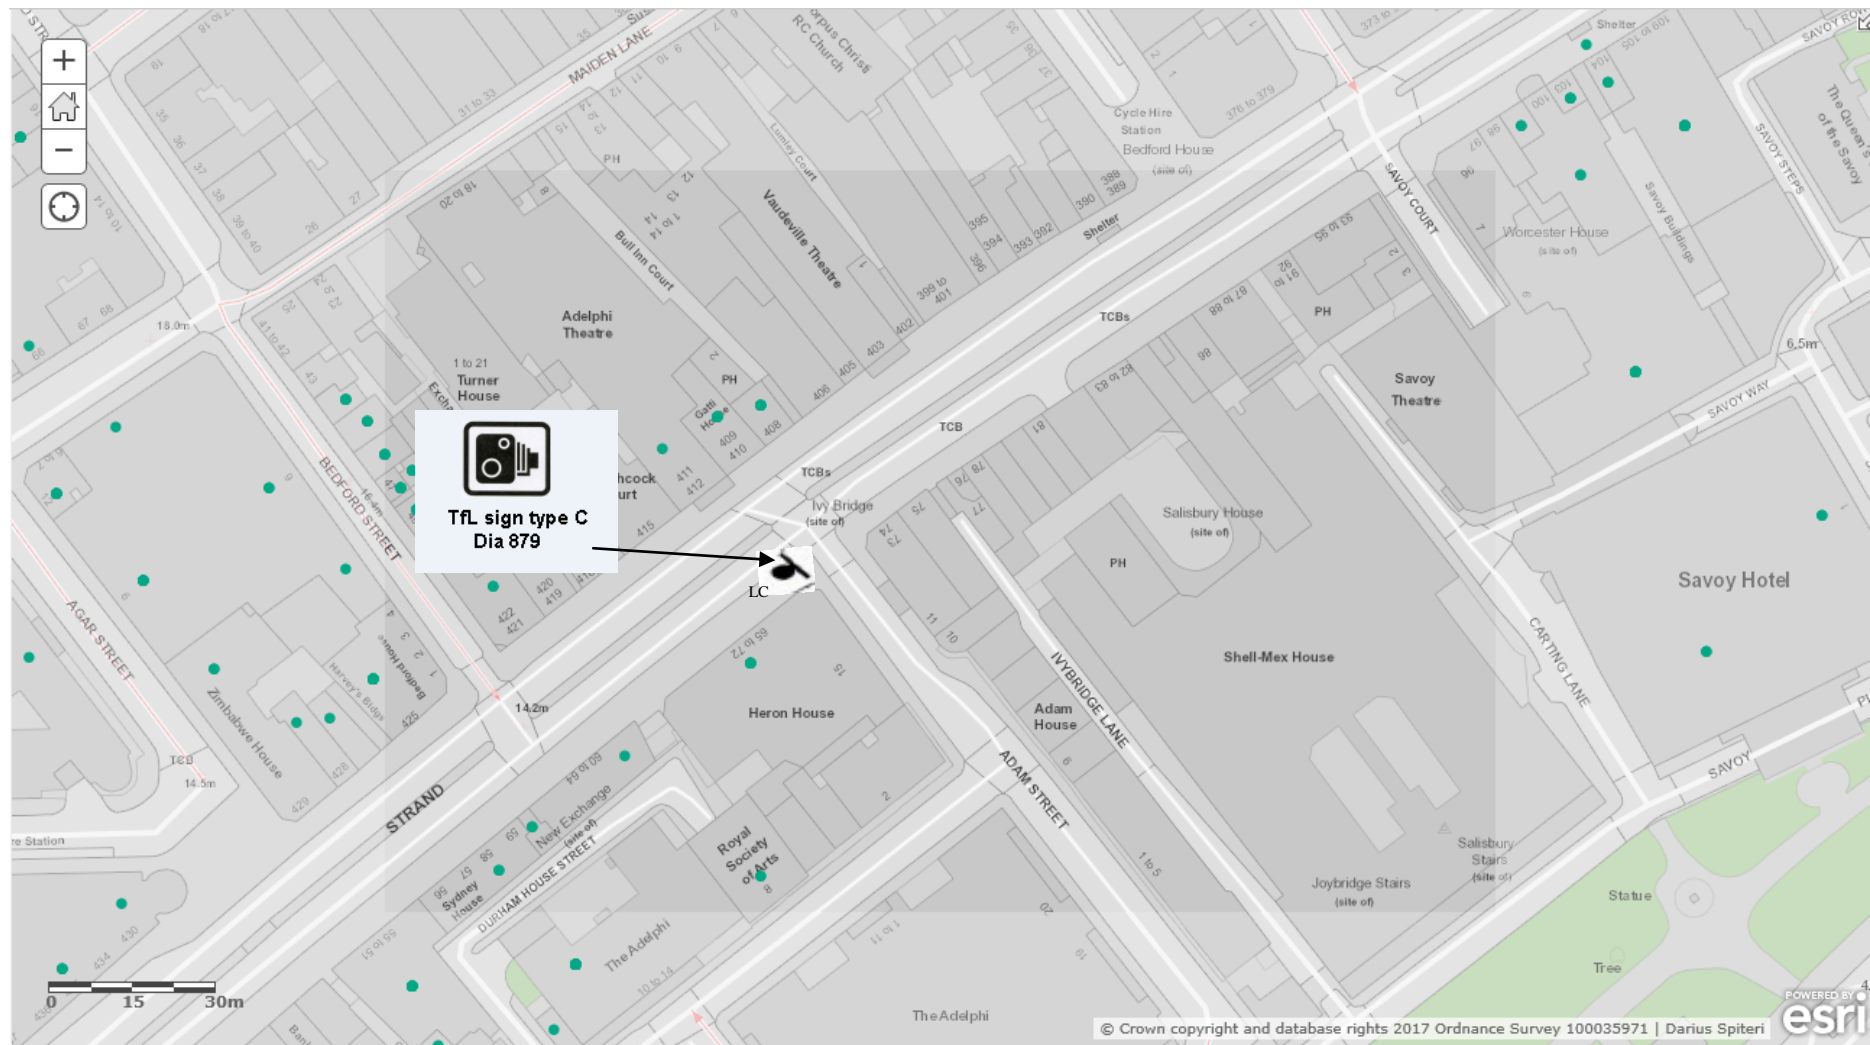

AS-BUILT

Congestion Charging Scheme

LN40002_AB_WE_081.9

The Strand
Wbnd, 5m w of jn with Adam
St, new post with bus lane sign