


LEGEND:			
□ H	EXISTING HOPPER BOX	△ TS	EXISTING TTS SIGNAL POLE
◦ LC	EXISTING LAMP COLUMN	⊠ TB	EXISTING TELEPHONE BOX
• LC	NEW LAMP COLUMN	⊞ PB	EXISTING POST BOX
⊞ SP	EXISTING SIGN POST	○ B	EXISTING BOLLARD
⊞ SP	NEW SIGN POST	□ IC	EXISTING INSPECTION CHAMBER
□ IGP	EXISTING IGP	○ TC	EXISTING TRAFFIC CAMERA
□ G	EXISTING GULLY	○ SC	EXISTING SPEED CAMERA
####	REMOVE EXISTING ROADMARKINGS	○ ECP	EXISTING ENFORCEMENT CAMERA POST
⦿	NEW ROAD MARKING TYPE TFL P TO BE LOCATED CENTRALLY IN LANE UNLESS SHOWN OTHERWISE		
⦿	NEW ROAD MARKING TYPE TFL O TO BE LOCATED CENTRALLY IN LANE UNLESS SHOWN OTHERWISE		
⦿	PROPOSED ENFORCEMENT CAMERA (BY OTHERS)		
⦿	PROPOSED CONTROL CABINET & FEEDER PILLAR (BY OTHERS)		

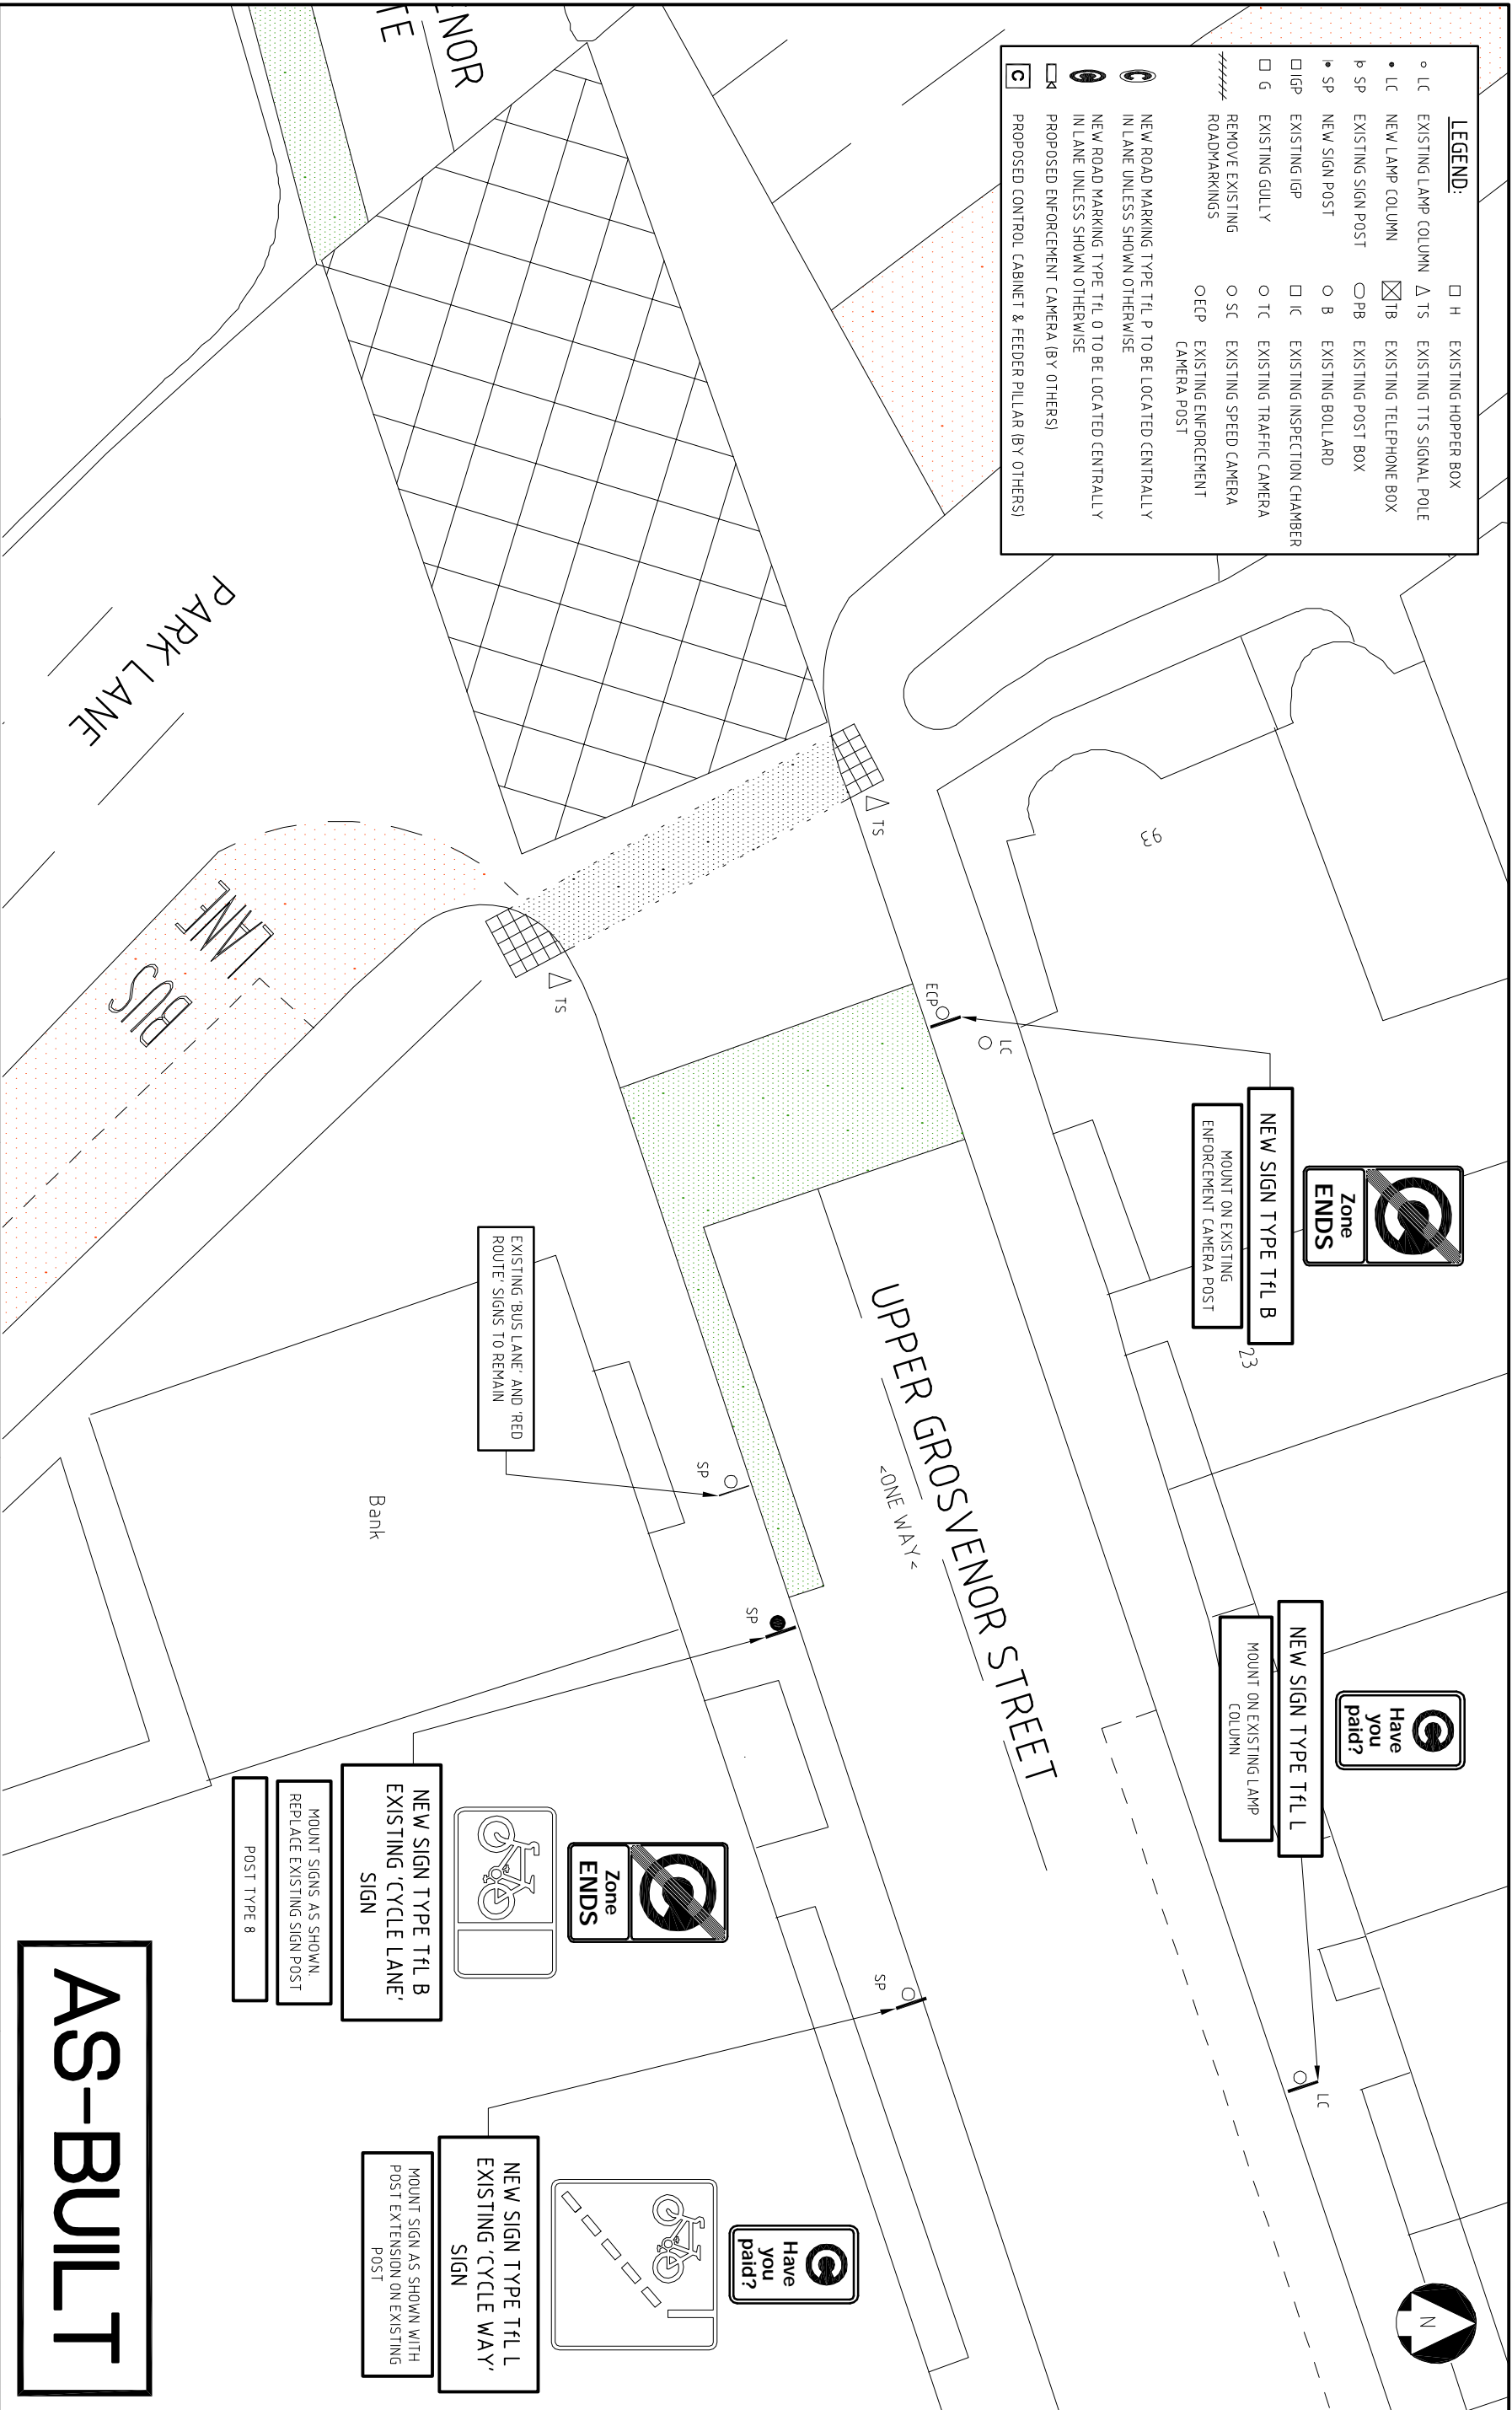

- Notes
1. ALL INSTRUCTIONS SHOWN DRAWING HAVE BEEN CARRIED OUT UNLESS NOTED OTHERWISE.
 2. ALL DIMENSIONS ARE SHOWN IN MILLIMETRES UNLESS OTHERWISE INDICATED
 3. CLEARANCE TO ALL SIGNS TO BE 450mm MIN. UNLESS SPECIFIED OTHERWISE
 4. SIGN MOUNTING HEIGHT TO BE 2m UNLESS SPECIFIED OTHERWISE

Rev	Description of Issue/Revision	Author	Chkd	Appd	Date
A	AS-BUILT	IG	RDP	GH	12/05/03
Designed	RDP	Drawn	IG	Datum	N/A

Location N:\LN40002\AS-BUILT\LN40002_AB_WE_118.DWG

Reproduced from based upon the
Ordinance Survey's 1:1250 maps
with the permission of the Controller
of HMSO. © Crown Copyright.
This drawing is the property of
Hyder Consulting and may lead to
prosecution or civil proceedings.
Title Licence Number: GD 00246

**Transport for London**
Street Management
Windsor House
42-50 Victoria Street
London SW1H 0TL
020 7343 5000

**Street Management**

Project		Title	
CONGESTION CHARGING SCHEME WESTMINSTER AREA		AS-BUILT BOUNDARY POINT LAYOUT 118 A4202 - PARK LANE / UPPER GROSVENOR STREET	
Hyder Consulting Limited 23 Bressenden Place London SW1E 5DZ		Scale A3 1:200	Date MARCH 2003 © Copyright Reserved
Dwg. No. LN40002/AB/WE/118		Rev A	