


LEGEND:	
<input type="checkbox"/> H	EXISTING HOPPER BOX
o LC	EXISTING LAMP COLUMN
Δ TS	EXISTING TTS SIGNAL POLE
• LC	NEW LAMP COLUMN
⊠ TB	EXISTING TELEPHONE BOX
b SP	EXISTING SIGN POST
⊖ PB	EXISTING POST BOX
h SP	NEW SIGN POST
o B	EXISTING BOLLARD
□ IGP	EXISTING IGP
□ IC	EXISTING INSPECTION CHAMBER
□ G	EXISTING GULLY
o TC	EXISTING TRAFFIC CAMERA
o SC	EXISTING SPEED CAMERA
////	REMOVE EXISTING ROADMARKINGS
o ECP	EXISTING ENFORCEMENT CAMERA POST
●	NEW ROAD MARKING TYPE TFL P TO BE LOCATED CENTRALLY IN LANE UNLESS SHOWN OTHERWISE
●	NEW ROAD MARKING TYPE TFL O TO BE LOCATED CENTRALLY IN LANE UNLESS SHOWN OTHERWISE
⊠	PROPOSED ENFORCEMENT CAMERA (BY OTHERS)
⊠	PROPOSED CONTROL CABINET & FEEDER PILLAR (BY OTHERS)

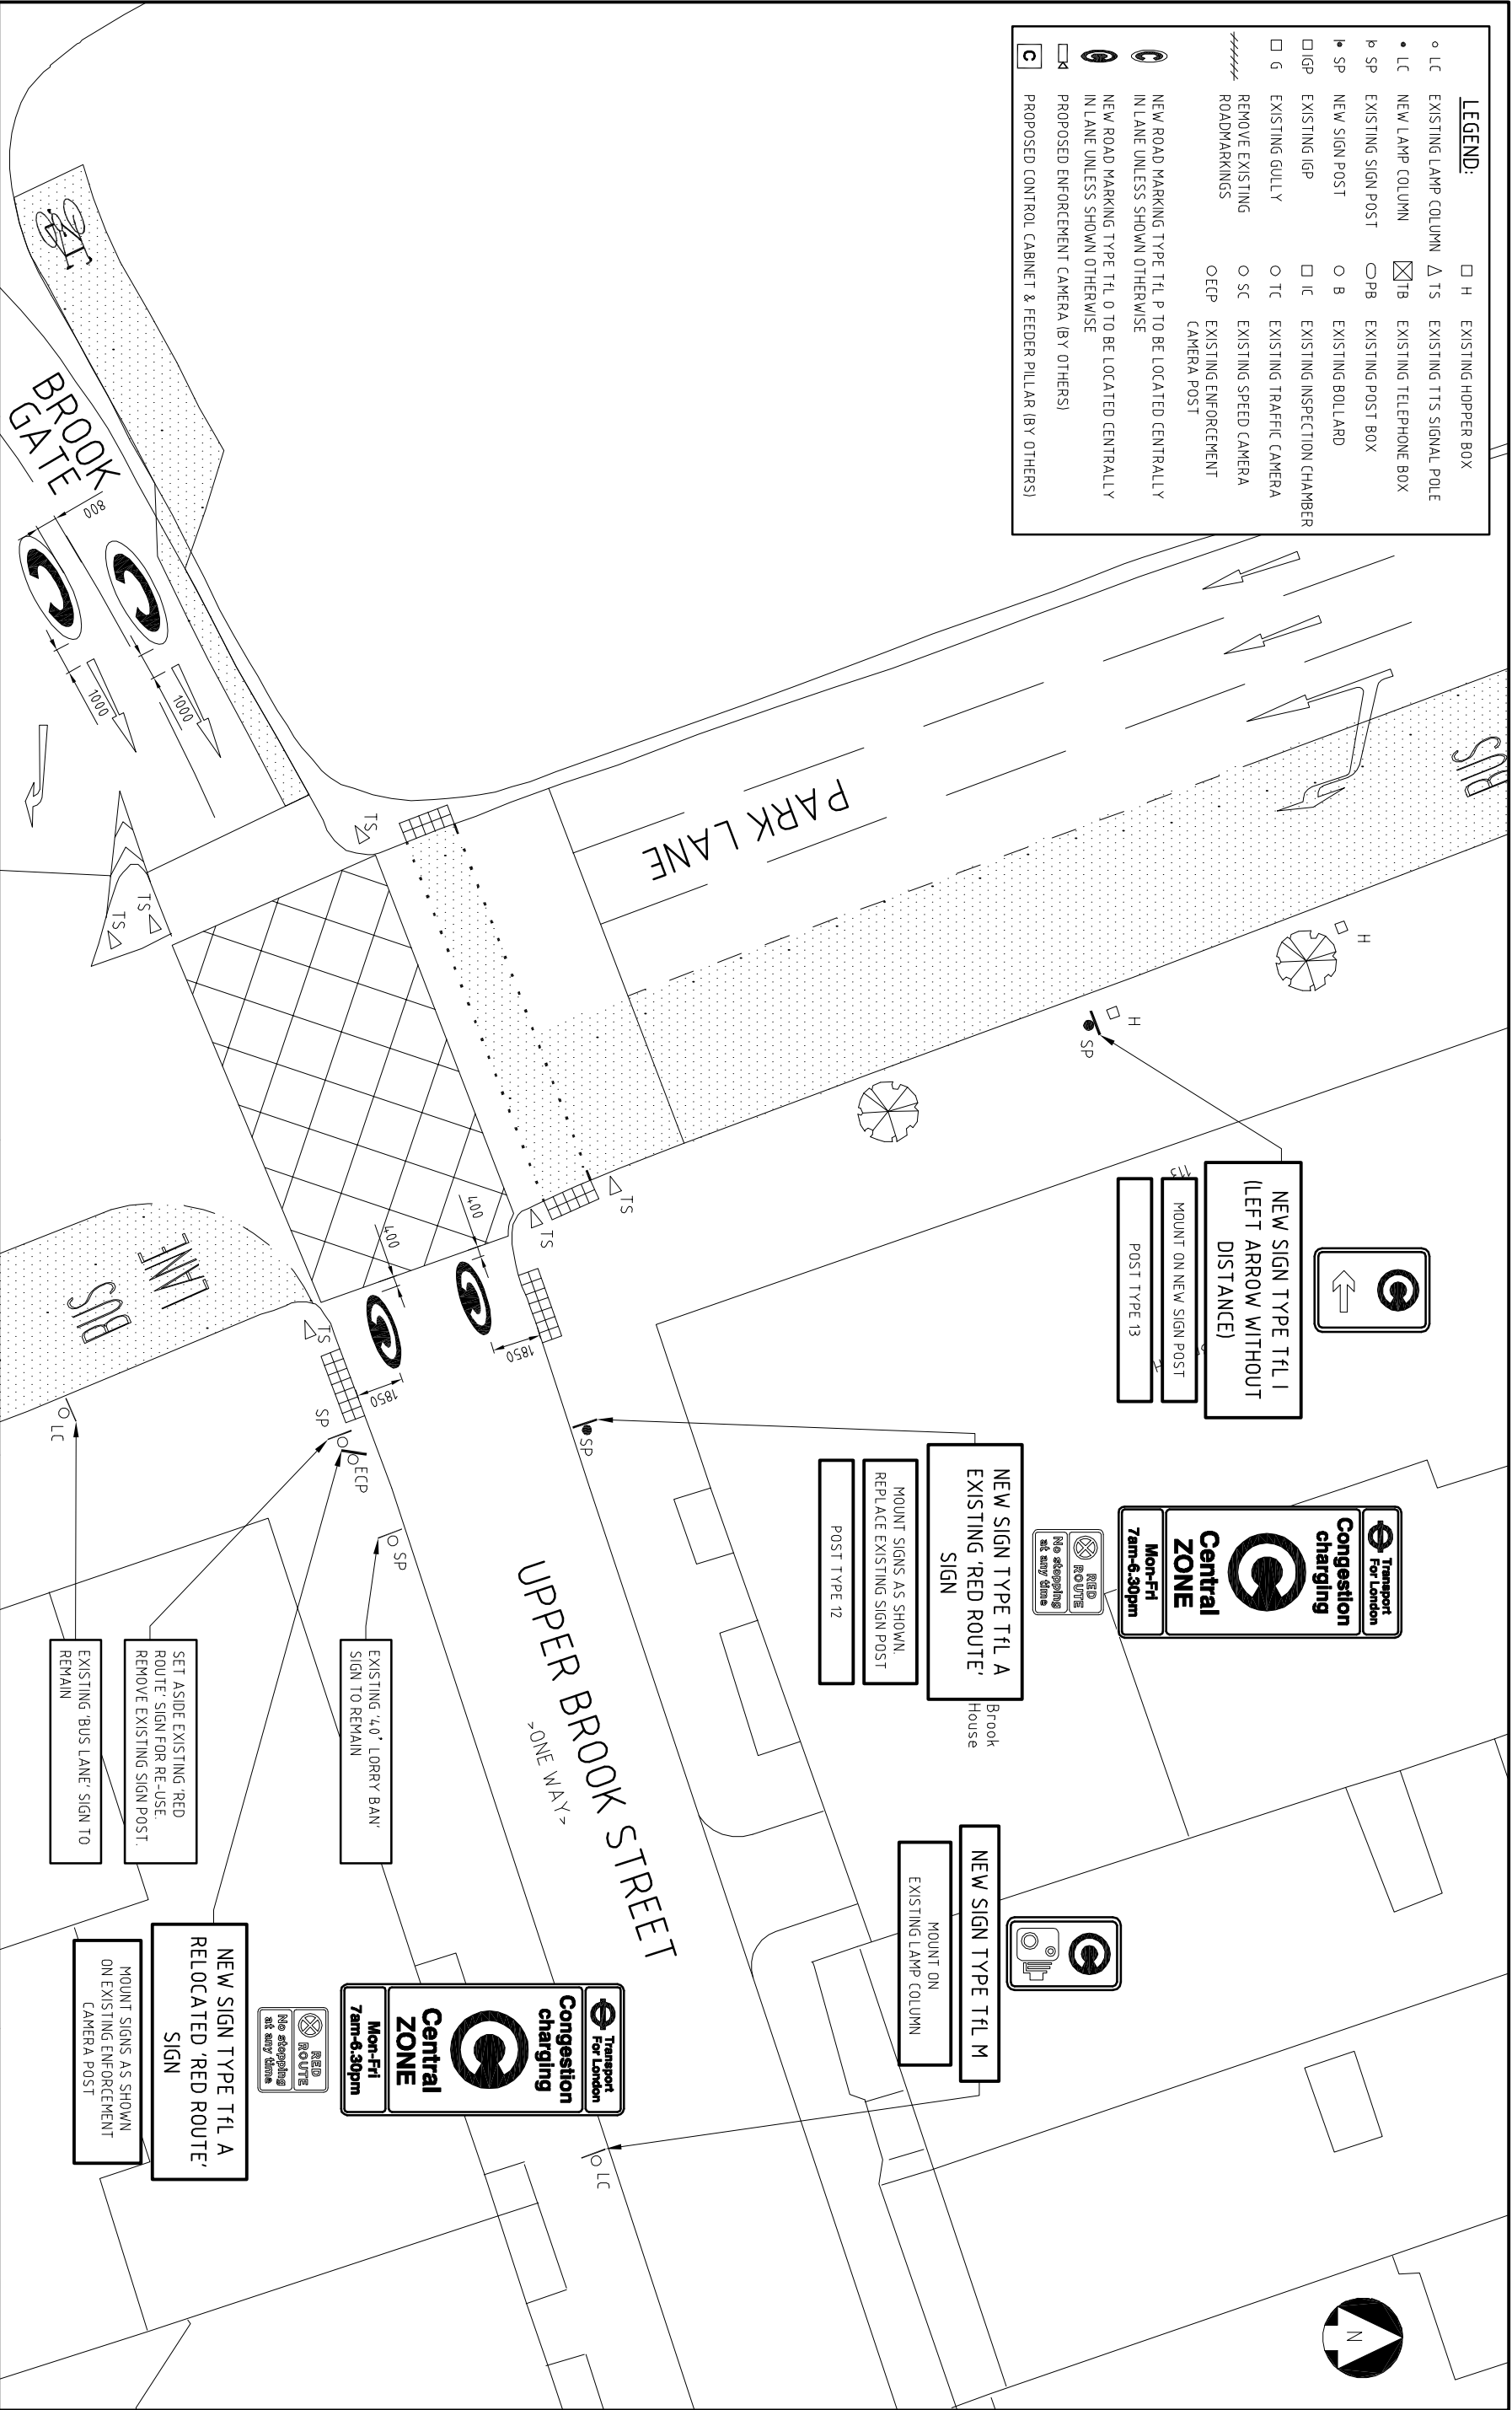

- Notes
1. ALL INSTRUCTIONS SHOWN DRAWING HAVE BEEN CARRIED OUT UNLESS NOTED OTHERWISE.
 2. ALL DIMENSIONS ARE SHOWN IN MILLIMETRES UNLESS OTHERWISE INDICATED
 3. CLEARANCE TO ALL SIGNS TO BE 45mm MIN. UNLESS SPECIFIED OTHERWISE
 4. SIGN MOUNTING HEIGHT TO BE 2m UNLESS SPECIFIED OTHERWISE

Rev	Description of Issue/Revision	Author	Chkd	Appd	Date
A	AS-BUILT	IG	RDP	GH	12/05/03
Designed	RDP	Drawn	IG	Datum	N/A

Reproduced from based upon the Ordnance Survey's 1:250 maps with the permission of the Controller of Her Majesty's Stationery Office. Crown copyright and may lead to prosecution or civil proceedings. TFL Licence Number: GD 00246

Transport for London
Street Management
Windsor House
42-50 Victoria Street
London SW1H 0TL
(020) 7343 5000

Project		Title	
CONGESTION CHARGING SCHEME WESTMINSTER AREA		AS-BUILT BOUNDARY POINT LAYOUT 116 A4.202 - PARK LANE / UPPER BROOK STREET	
Hyder Consulting Limited 29 Bressenden Place London SW1E 5DZ		Scale A3 1:250	Date MARCH 2003
Dwg. No. LN40002/AB/WE/116		© Copyright Reserved	
		Rev A	

PLOT DATE: 12/03/03