


LEGEND:	
<input type="checkbox"/> H	EXISTING HOPPER BOX
o LC	EXISTING LAMP COLUMN
Δ TS	EXISTING TTS SIGNAL POLE
• LC	NEW LAMP COLUMN
<input checked="" type="checkbox"/> TB	EXISTING TELEPHONE BOX
p SP	EXISTING SIGN POST
<input type="checkbox"/> PB	EXISTING POST BOX
h SP	NEW SIGN POST
o B	EXISTING BOLLARD
<input type="checkbox"/> IGP	EXISTING IGP
<input type="checkbox"/> IC	EXISTING INSPECTION CHAMBER
<input type="checkbox"/> G	EXISTING GULLY
o TC	EXISTING TRAFFIC CAMERA
o SC	EXISTING SPEED CAMERA
////	REMOVE EXISTING ROADMARKINGS
o ECP	EXISTING ENFORCEMENT CAMERA POST
	NEW ROAD MARKING TYPE TFL P TO BE LOCATED CENTRALLY IN LANE UNLESS SHOWN OTHERWISE
	NEW ROAD MARKING TYPE TFL O TO BE LOCATED CENTRALLY IN LANE UNLESS SHOWN OTHERWISE
<input checked="" type="checkbox"/> CA	PROPOSED ENFORCEMENT CAMERA (BY OTHERS)
<input checked="" type="checkbox"/> C	PROPOSED CONTROL CABINET & FEEDER PILLAR (BY OTHERS)

Westminster
Council House

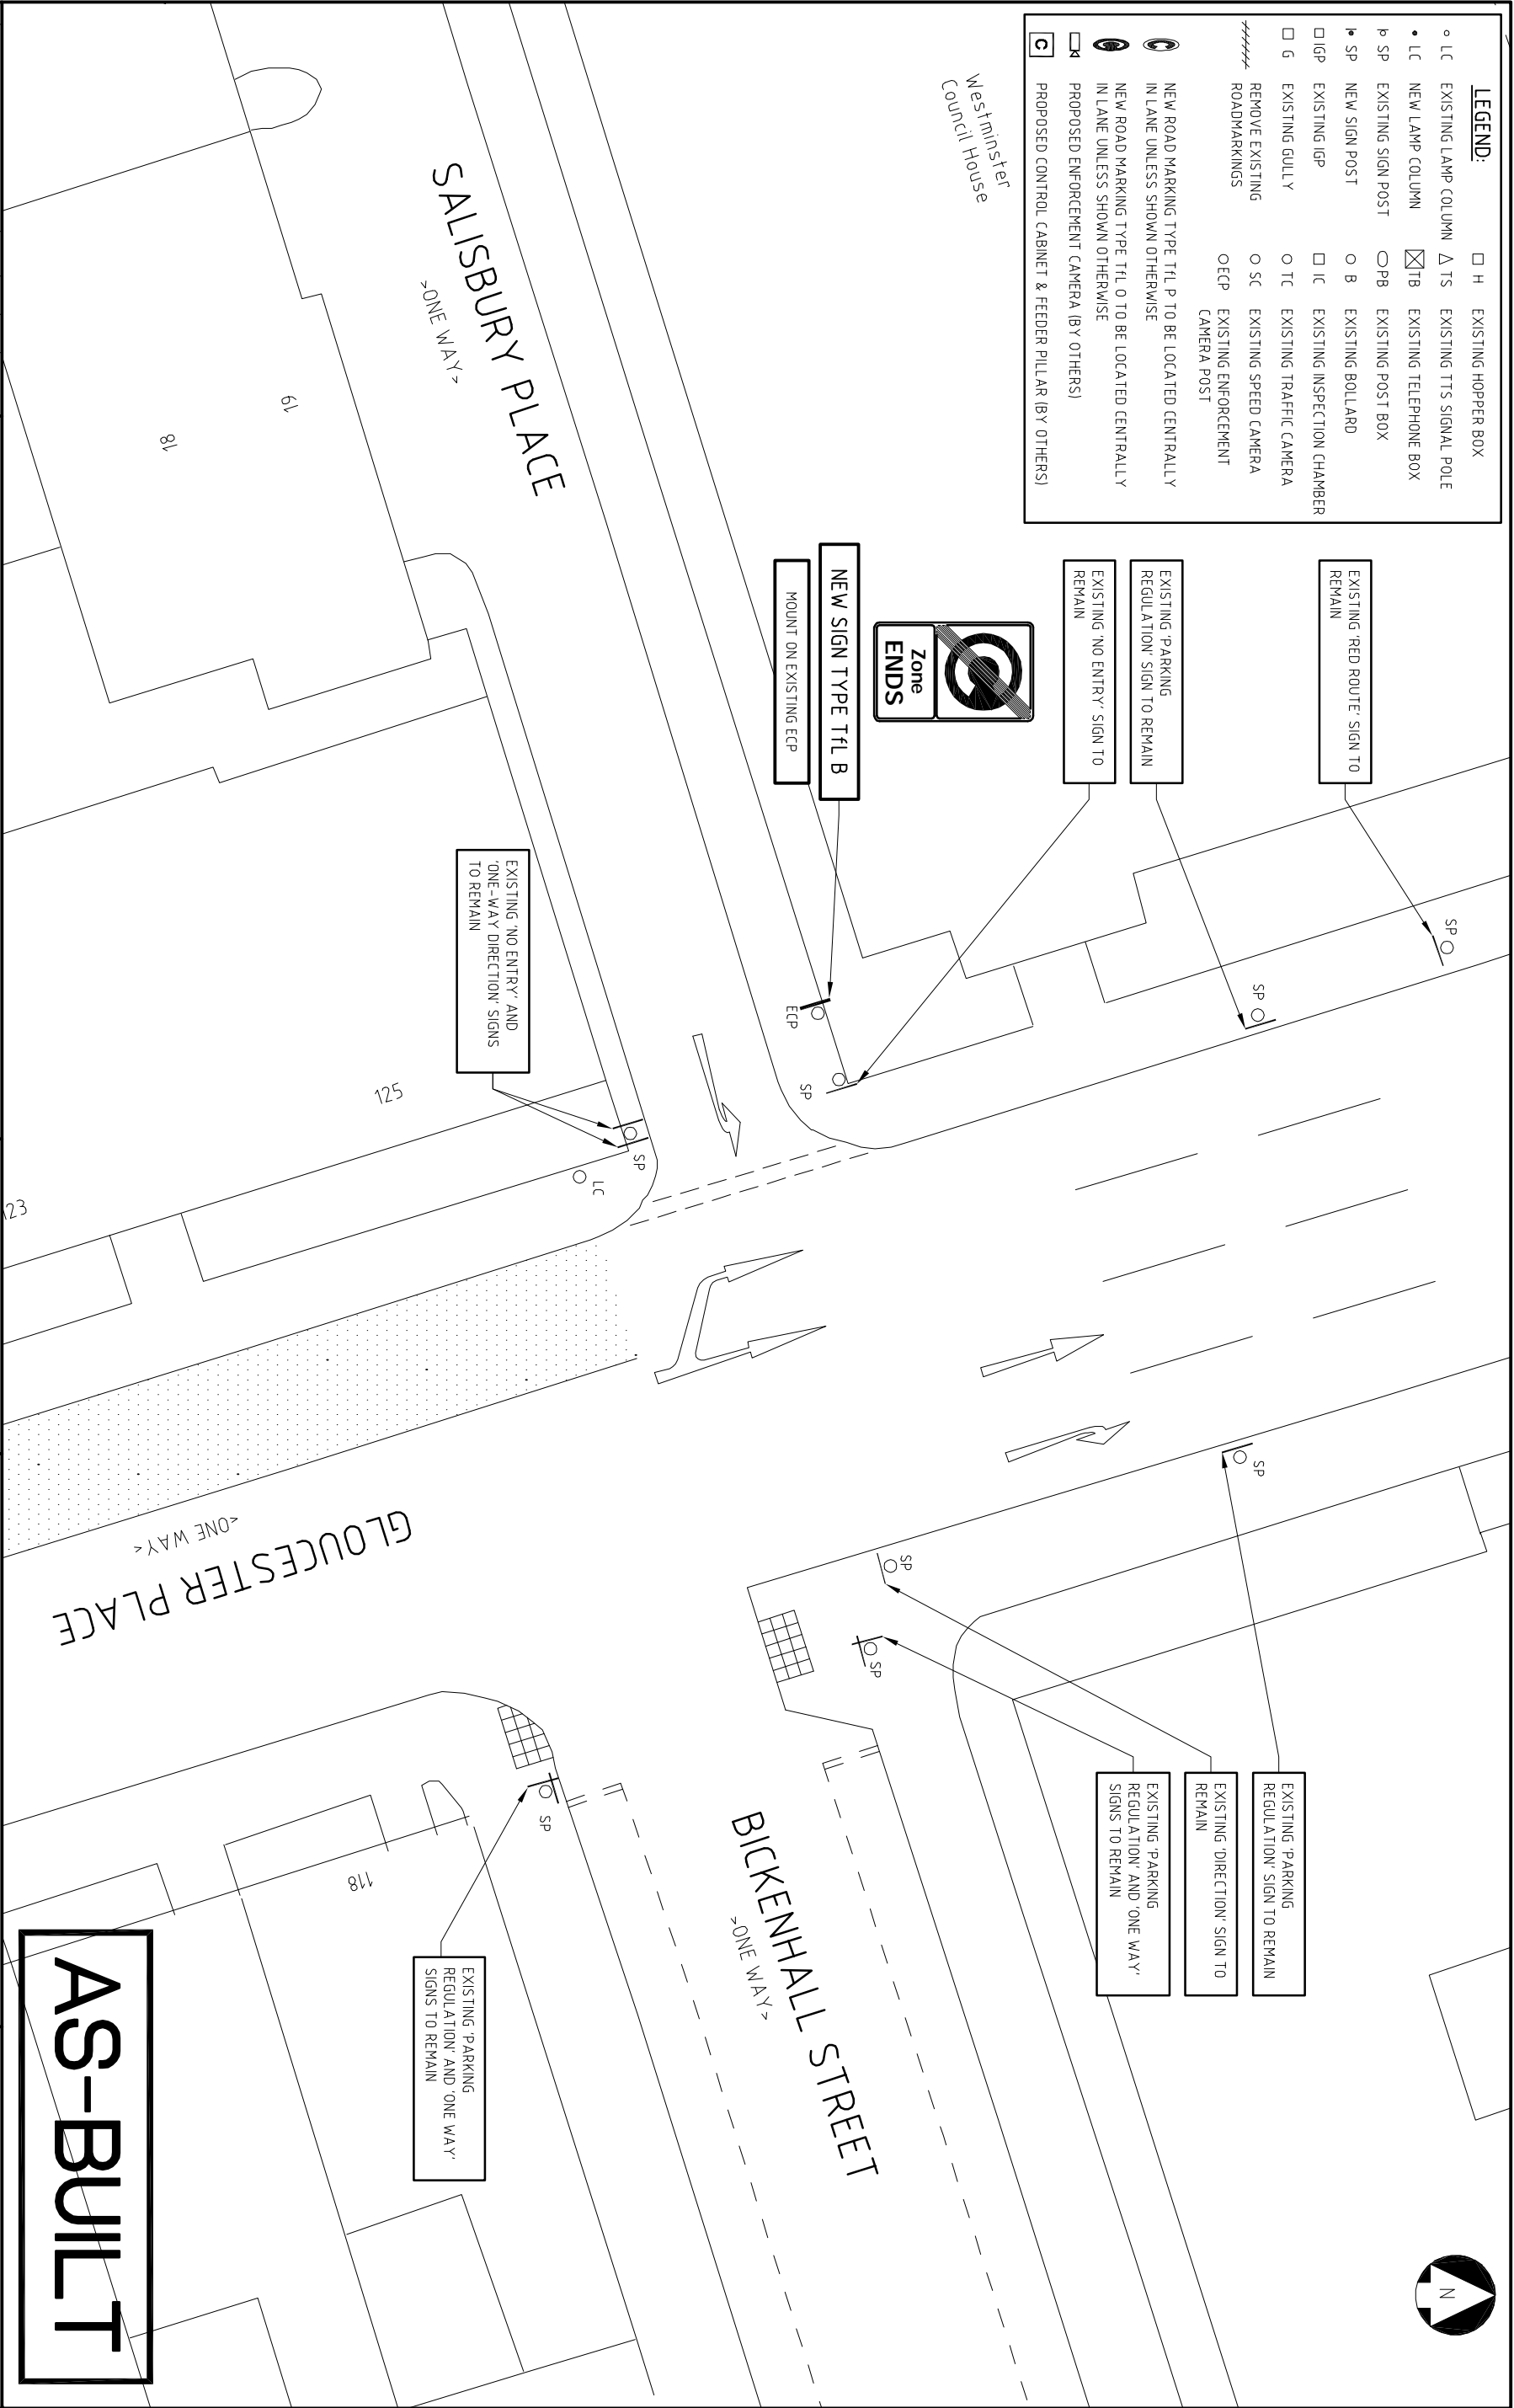

- Notes
1. ALL INSTRUCTIONS SHOWN DRAWING HAVE BEEN CARRIED OUT UNLESS NOTED OTHERWISE.
 2. ALL DIMENSIONS ARE SHOWN IN MILLIMETRES UNLESS OTHERWISE INDICATED
 3. CLEARANCE TO ALL SIGNS TO BE 450mm MIN. UNLESS SPECIFIED OTHERWISE
 4. SIGN MOUNTING HEIGHT TO BE 2m UNLESS SPECIFIED OTHERWISE

Rev	Description of Issue/Revision	Author	Chkd	Appd	Date
A	AS-BUILT	IG	RDP	GH	12/05/03
Designed	RDP	Drawn	IG	Datum	N/A

Location N:\LN4\0002\AS-BUILT\LN4\0002_AB_WE_094.DWG

Reproduced from plans upon the
Ordinance Survey's 1:1250 maps
with the permission of the Controller
of HMSO. © Crown Copyright.
No part of this publication may be
reproduced or stored in a retrieval
system without prior written
permission of the Controller.
TFL Licence Number: GD 00246



Transport for London
Street Management



Street Management

42-50 Victoria Street
London SW14 0TL
(020) 7343 5000

CONGESTION CHARGING SCHEME
WESTMINSTER AREA

AS-BUILT BOUNDARY POINT LAYOUT 094
GLOUCESTER PLACE / SALISBURY PLACE



Hyder Consulting Limited
23 Bressenden Place
London SW1E 5DZ

Scale	Date	Rev
A3 1:200	MARCH 2003	A
© Copyright Reserved		