


DUKE OF WELLINGTON PLACE

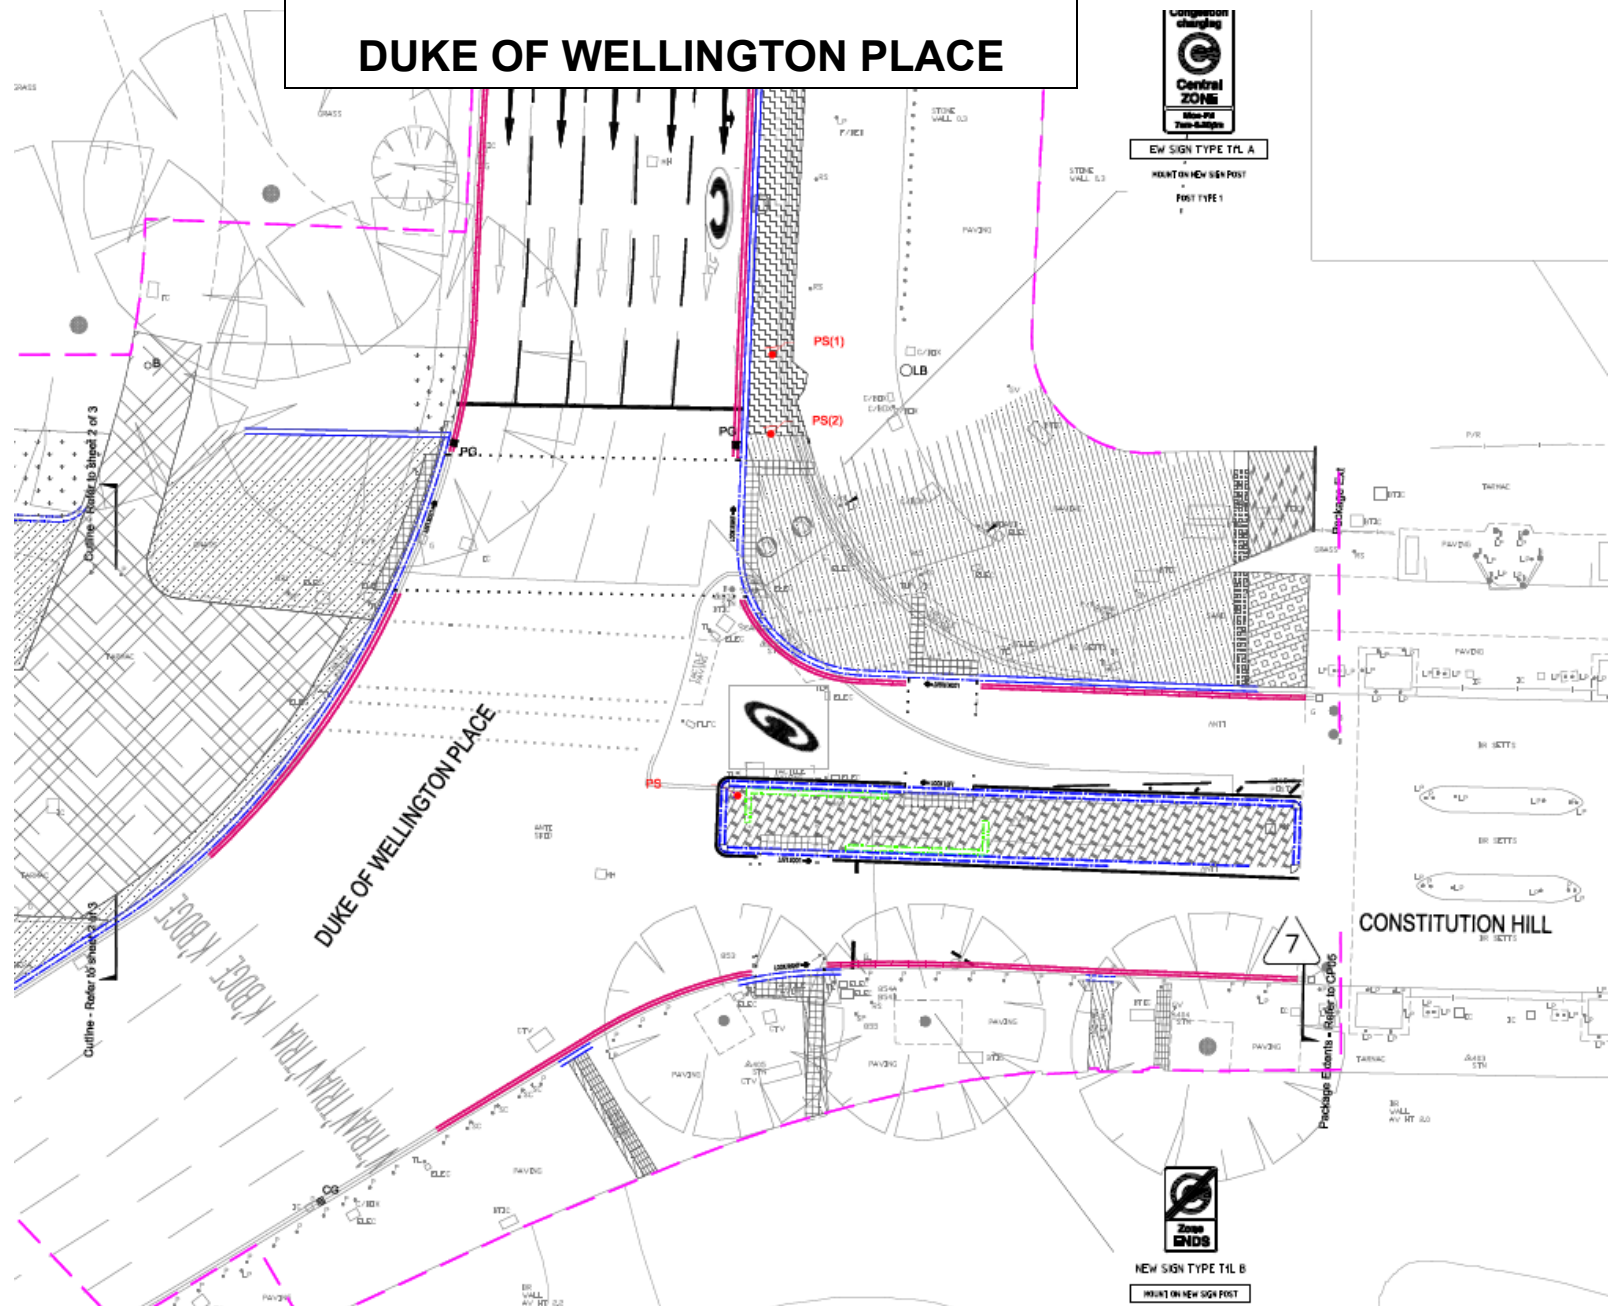

AS-BUILT

Congestion Charging Scheme Southwark

LN40002_AB_WE_127.1.PDF

Duke of Wellington Place