


Charing Cross Road

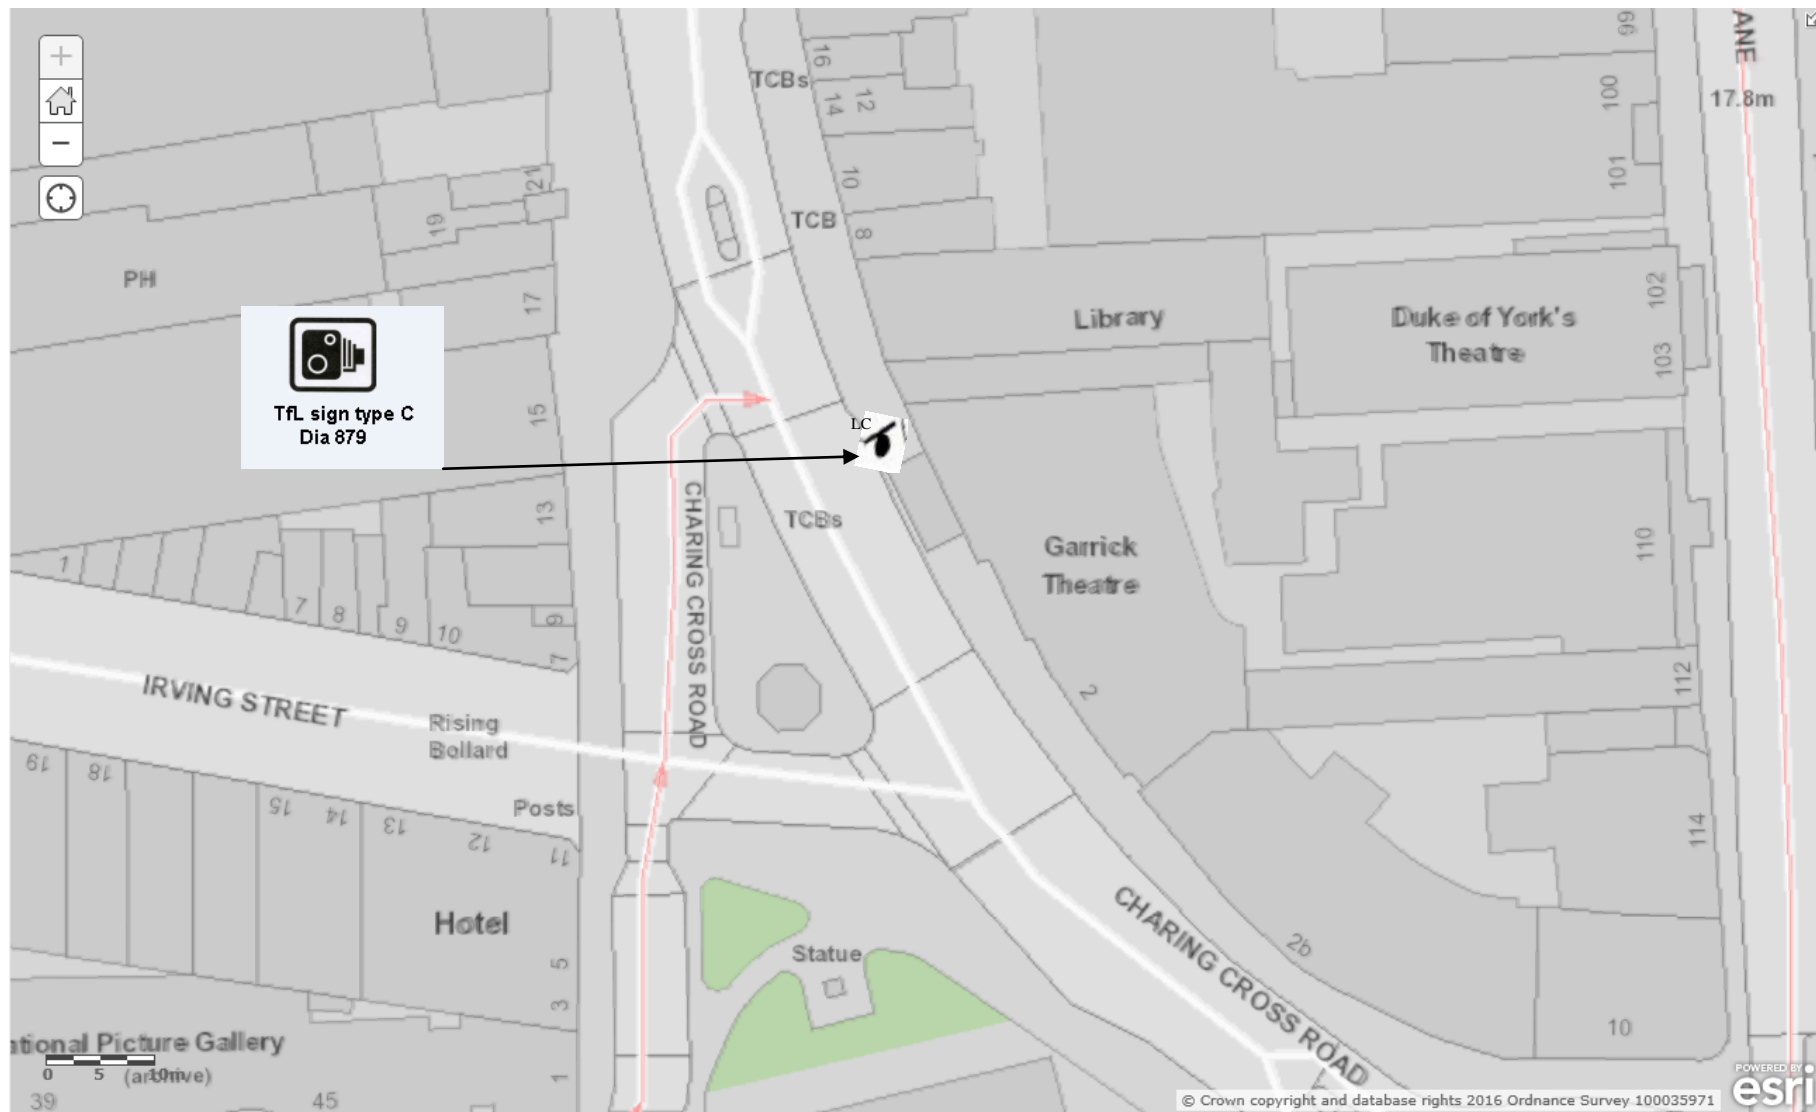

AS-BUILT

Congestion Charging Scheme

LN40002_AB_WE_081.5

CHARING CROSS RD OS
GARRICK THEATRE SB
BEFORE ST MARTINS
PLACE