


# Marble Arch Nov 2016

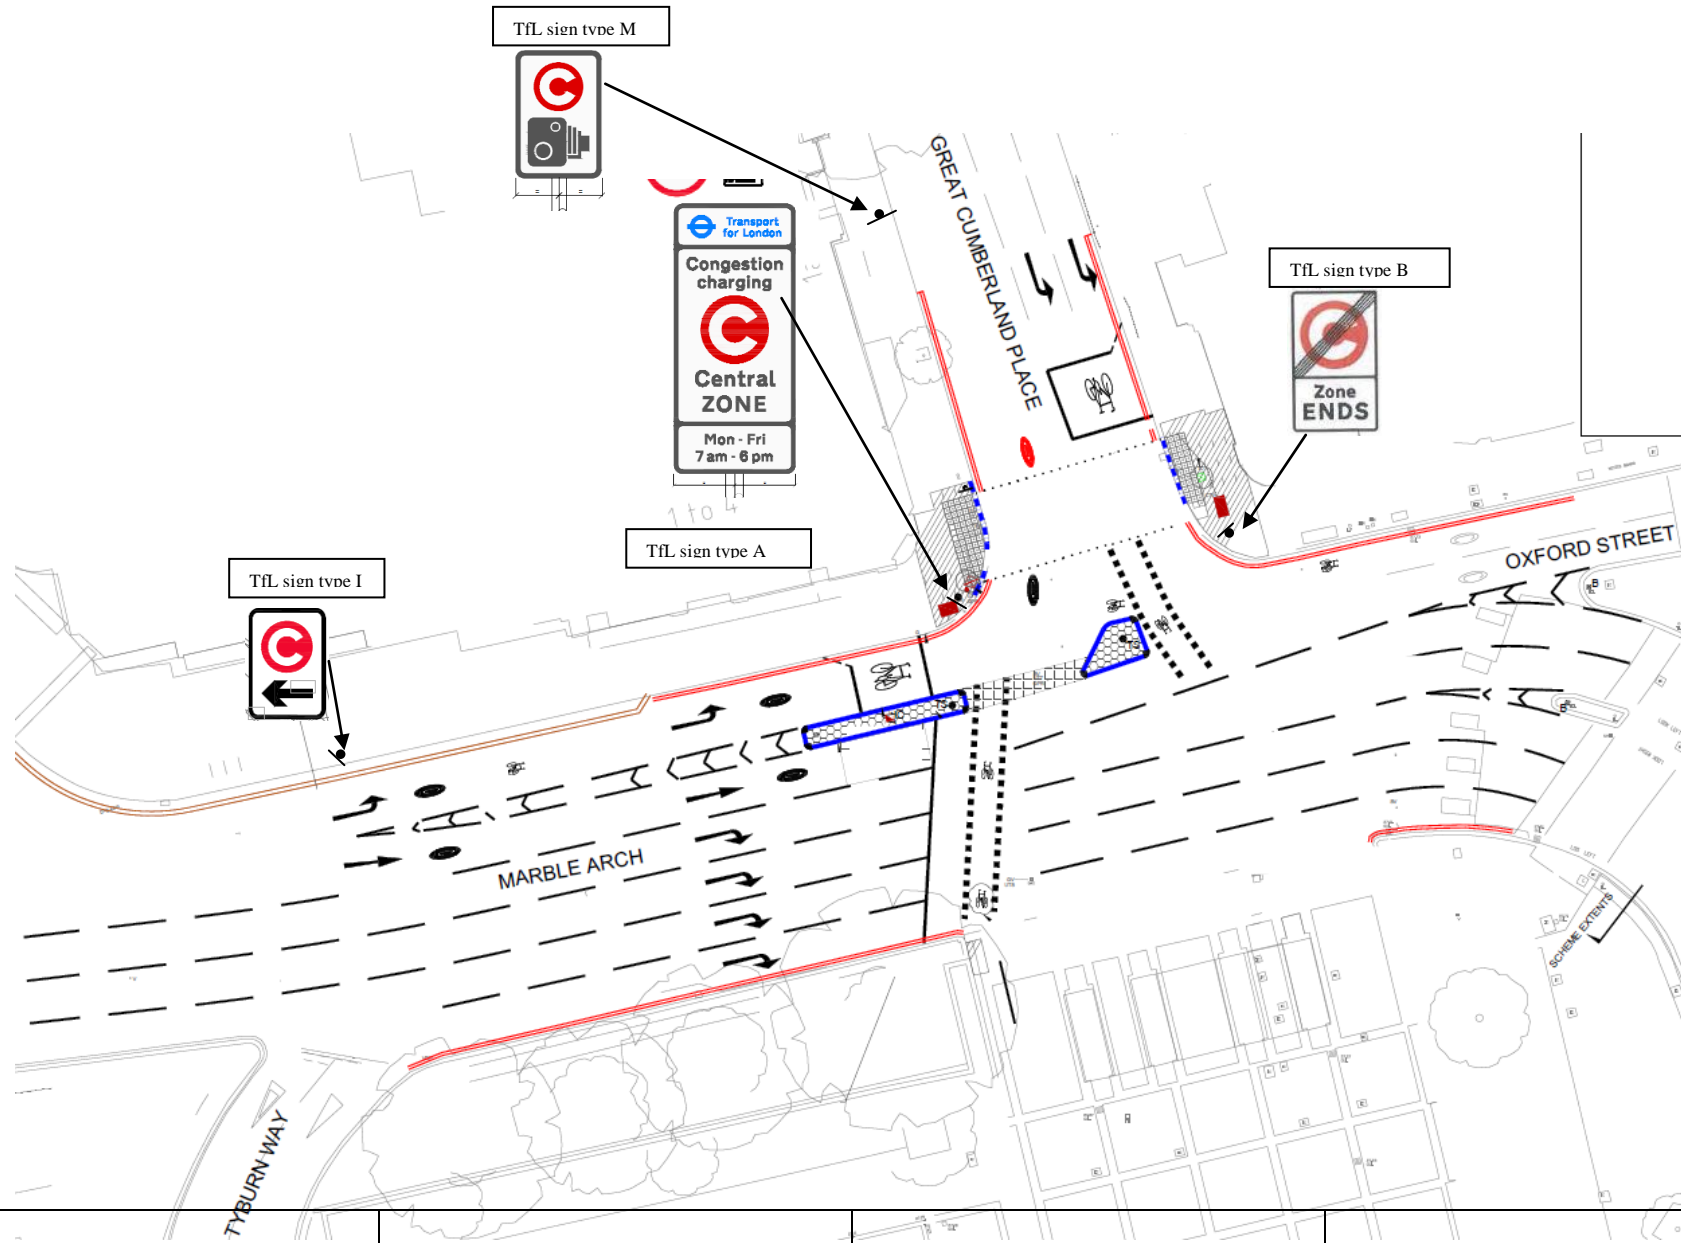

AS-BUILT

Congestion Charging Scheme

LN40002\_AB\_WE\_111.1

Marble Arch Jcn Grt Cumberland Place