


Charing Cross Road

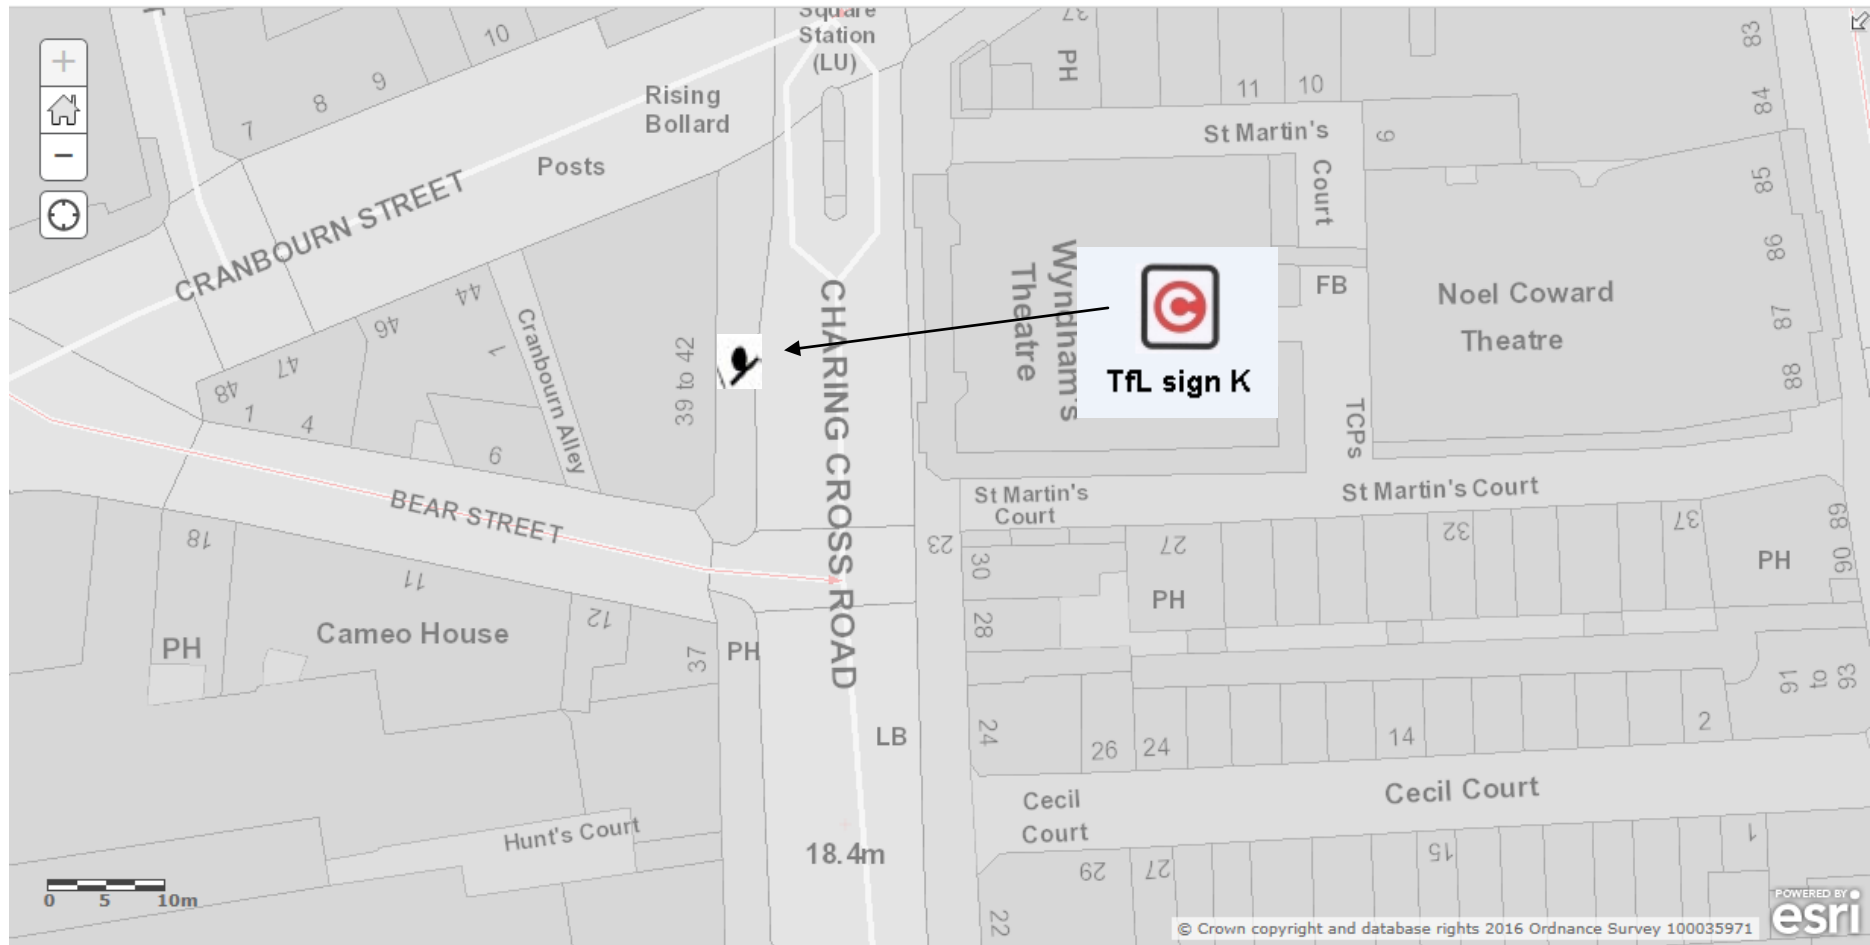

AS-BUILT

Congestion Charging Scheme

LN40002_AB_WE_081.7

Charing Cross Road Nbd, s of jn
with Cranbourne St, o/s no 41, on LC
28 near to Ladbrookes