


Road layout varied 24th February 2019
during Baker Street 2 way switch project

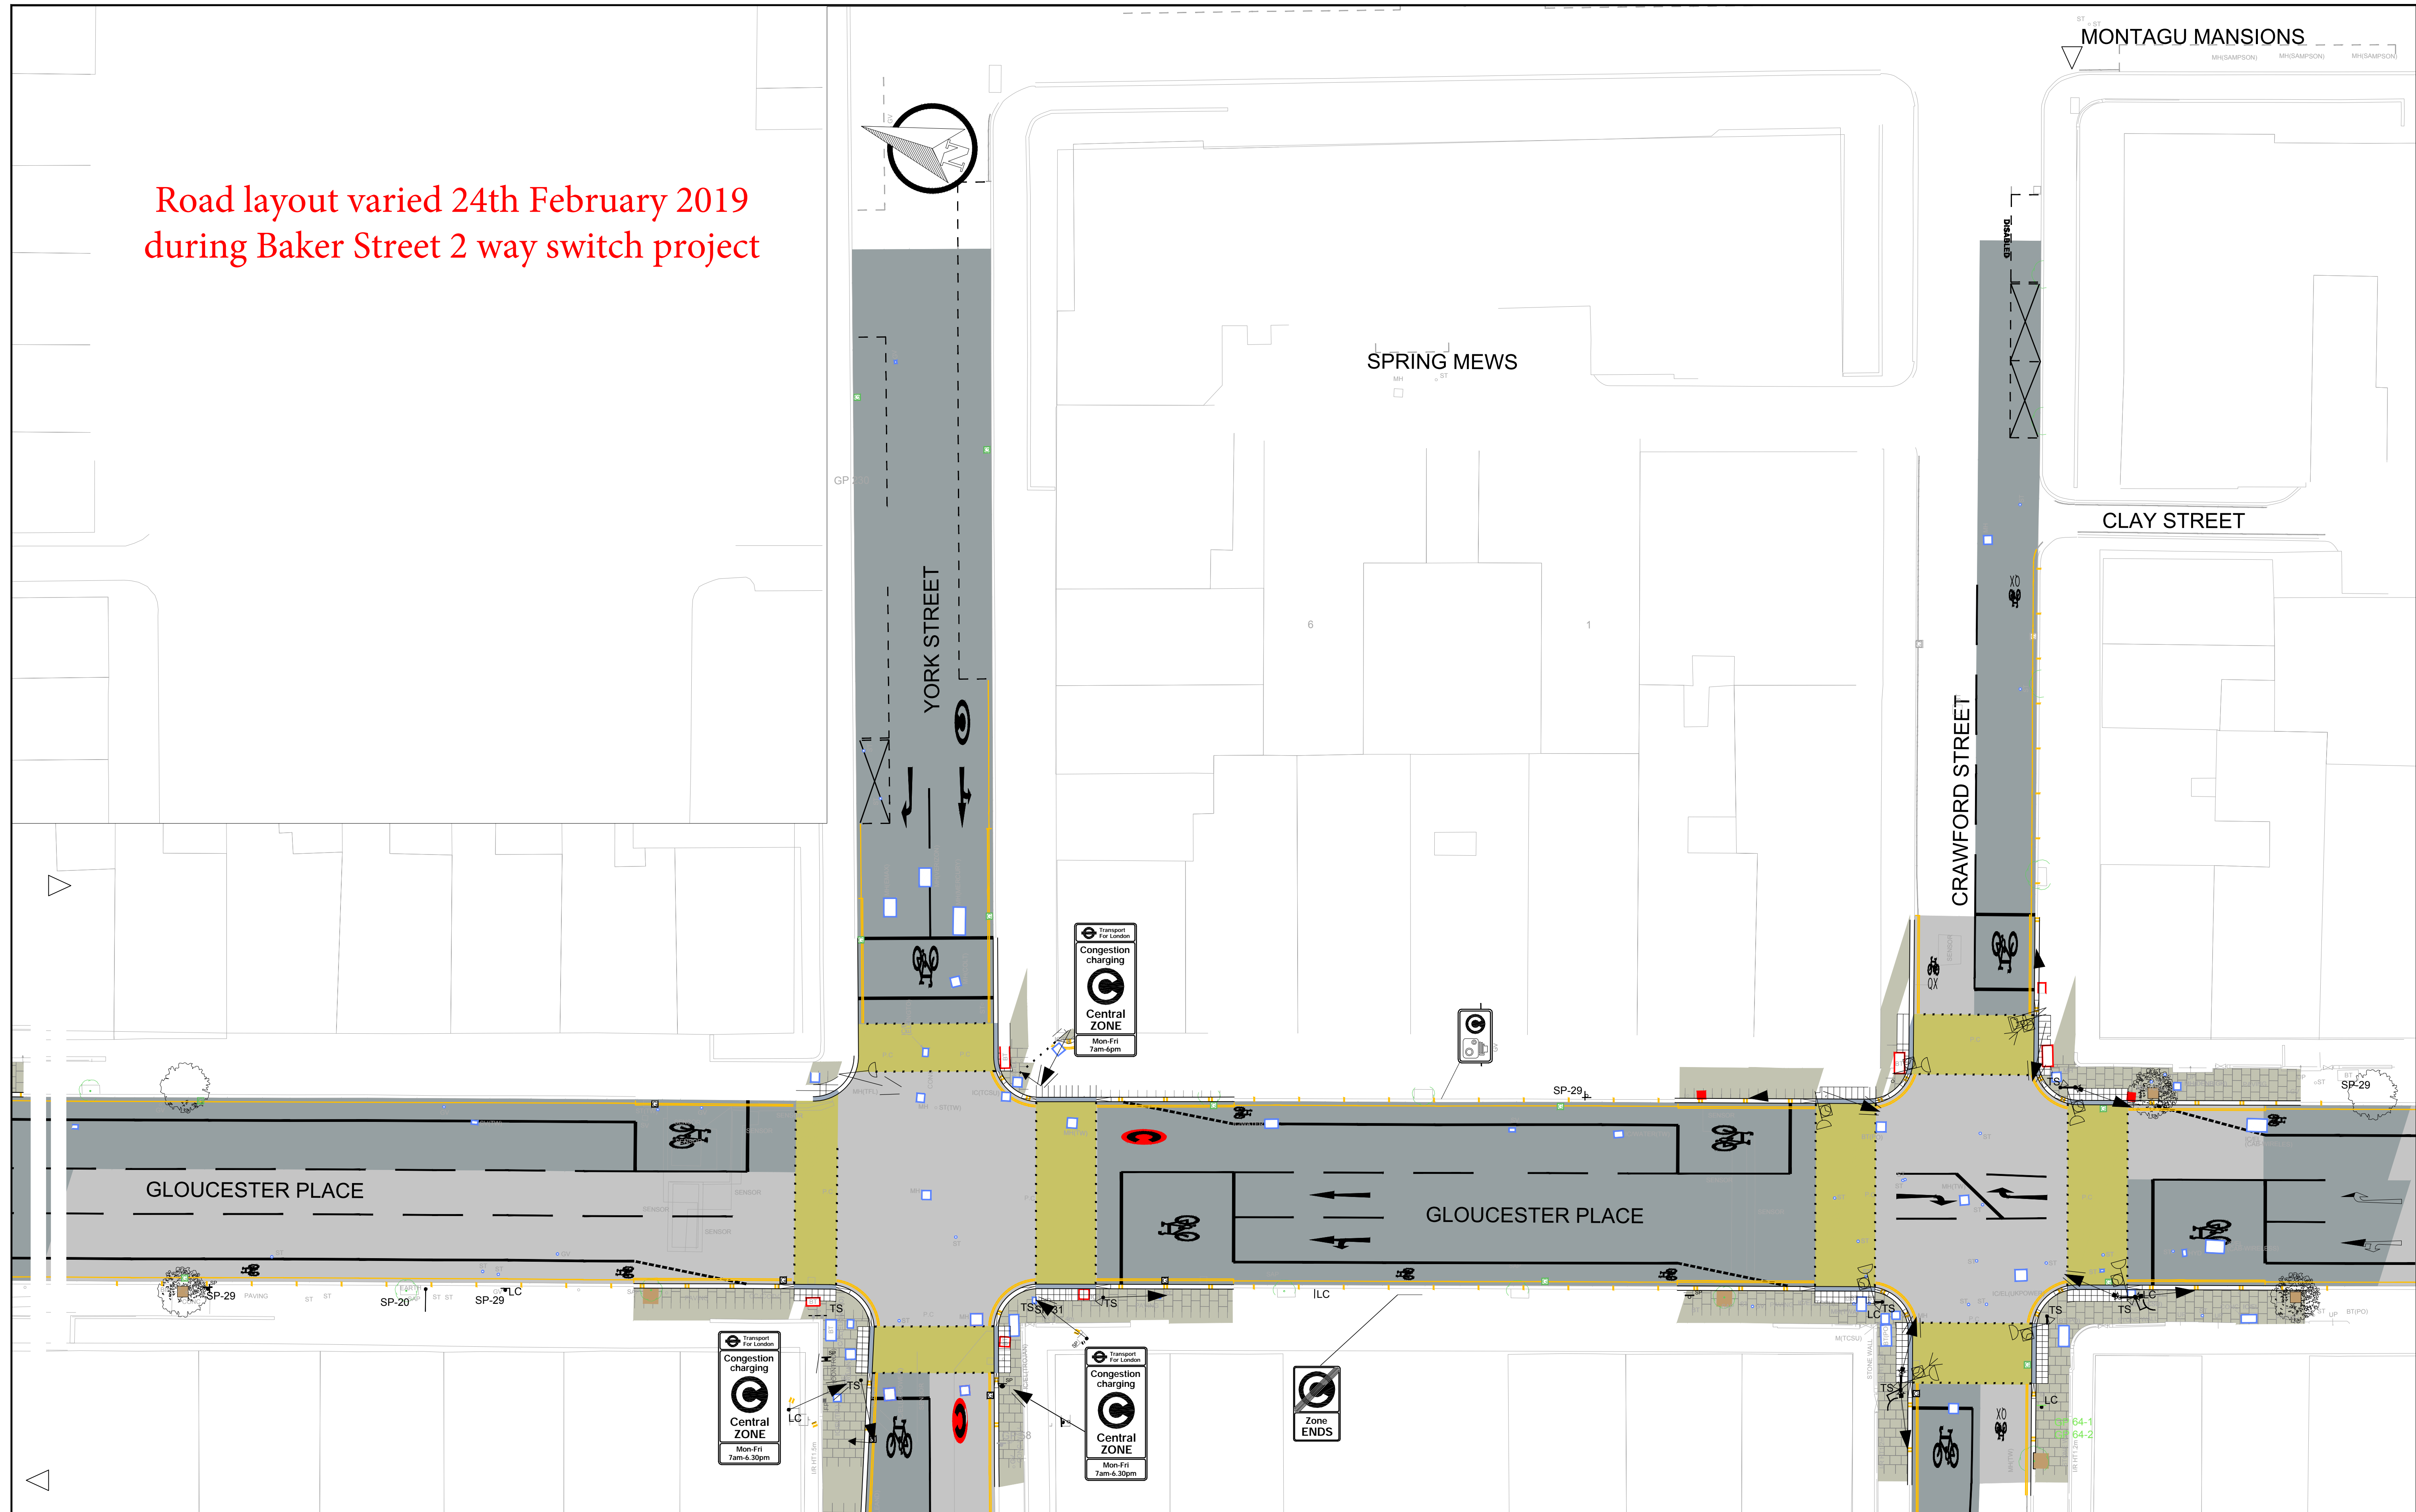

AS-BUILT

CONGESTION CHARGING SCHEME
WESTMINSTER AREA

AS-BUILT BOUNDARY
POINT LAYOUT 088.2
A501 - MARYLEBONE
ROAD / YORK STREET

Reproduced from/based upon the Ordnance Survey's
1:1250 maps with the permission of the Controller of
HMSSO, Crown Copyright,

Unauthorised reproduction infringes
Crown copyright and may lead to prosecution or
civil proceedings. TfL Licence Number : GD 030426

Transport for London Road
user Charging Windsor
House
42-50 Victoria Street
London SW1H 0TL

LN40002/AB/WE/092_93A

REV	DATE				