


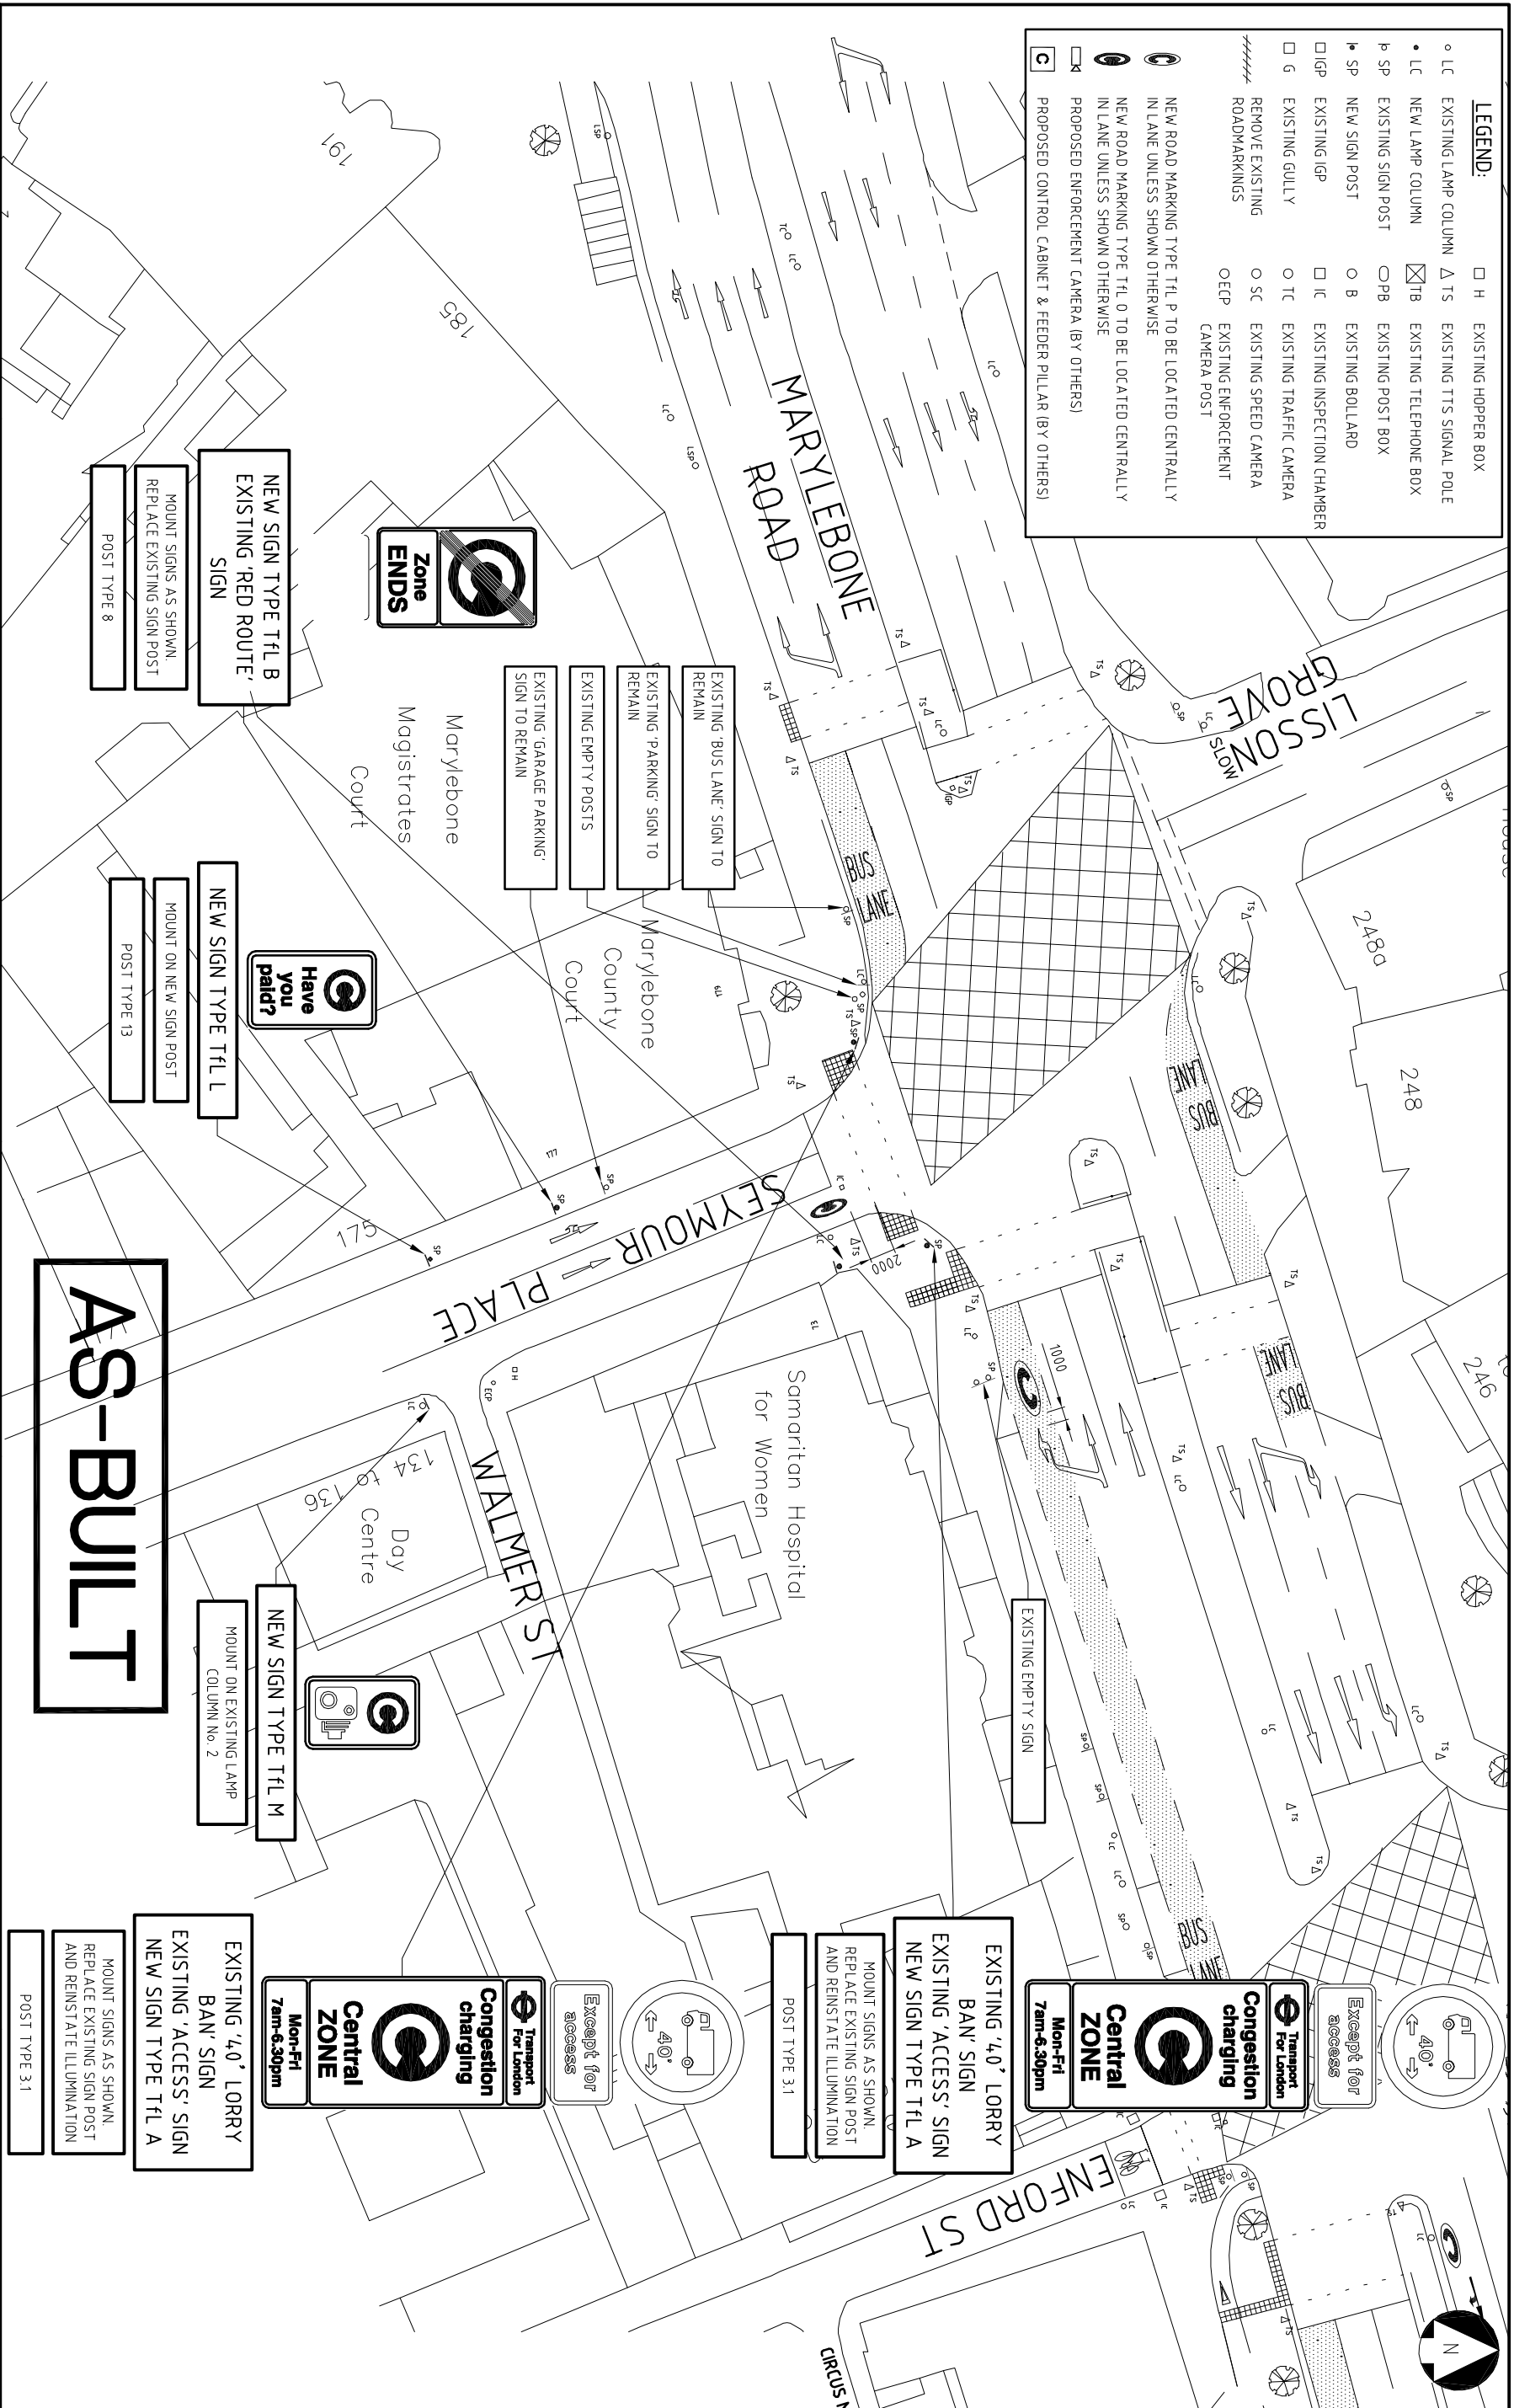


LEGEND:	
<input type="checkbox"/> H	EXISTING HOPPER BOX
<input type="radio"/> LC	EXISTING LAMP COLUMN
<input type="radio"/> LC	NEW LAMP COLUMN
<input type="radio"/> b SP	EXISTING SIGN POST
<input type="radio"/> SP	NEW SIGN POST
<input type="checkbox"/> IGP	EXISTING IGP
<input type="checkbox"/> G	EXISTING GULLY
////	REMOVE EXISTING ROADMARKINGS
<input type="radio"/> O SC	EXISTING SPEED CAMERA
<input type="radio"/> O TC	EXISTING TRAFFIC CAMERA
<input type="checkbox"/> IC	EXISTING INSPECTION CHAMBER
<input type="checkbox"/> O B	EXISTING BOLLARD
<input type="checkbox"/> O PB	EXISTING POST BOX
<input checked="" type="checkbox"/> TB	EXISTING TELEPHONE BOX
<input type="checkbox"/> TS	EXISTING TTS SIGNAL POLE
<input type="radio"/> LC	NEW ROAD MARKING TYPE TFL P TO BE LOCATED CENTRALLY IN LANE UNLESS SHOWN OTHERWISE
<input type="radio"/> LC	NEW ROAD MARKING TYPE TFL O TO BE LOCATED CENTRALLY IN LANE UNLESS SHOWN OTHERWISE
<input type="checkbox"/> CA	PROPOSED ENFORCEMENT CAMERA (BY OTHERS)
<input type="checkbox"/> CB	PROPOSED CONTROL CABINET & FEEDER PILLAR (BY OTHERS)



					Notes			
					1. ALL INSTRUCTIONS SHOWN DRAWING HAVE BEEN CARRIED OUT UNLESS NOTED OTHERWISE			
					2. ALL DIMENSIONS ARE SHOWN IN MILLIMETRES UNLESS OTHERWISE INDICATED			
					3. CLEARANCE TO ALL SIGNS TO BE 450mm MIN UNLESS SPECIFIED OTHERWISE			
					4. SIGN MOUNTING HEIGHT TO BE 2m UNLESS SPECIFIED OTHERWISE			
A AS-BUILT					IG	RDP	GH	12/05/03
Rev	Description of Issue/Revision	Author	Chkd	Appd	Date			
Designed	RDP	Drawn	IG	Datum	N/A			
Location N:\LN40002\AS-BUILT\LN40002_AB_WE_099.DWG								
<div>1. ALL INSTRUCTIONS SHOWN DRAWING HAVE BEEN CARRIED OUT UNLESS NOTED OTHERWISE</div> <div>2. ALL DIMENSIONS ARE SHOWN IN MILLIMETRES UNLESS OTHERWISE INDICATED</div> <div>3. CLEARANCE TO ALL SIGNS TO BE 450mm MIN UNLESS SPECIFIED OTHERWISE</div> <div>4. SIGN MOUNTING HEIGHT TO BE 2m UNLESS SPECIFIED OTHERWISE</div>								
<div>Reproduced from plans issued under the Ordnance Survey's 1:12500 maps with the permission of the Controller of HMSO. © Crown Copyright. All rights reserved. No part of this publication may be reproduced, stored in a retrieval system or transmitted in any form or by any means, electronic, mechanical, photocopying, recording or otherwise, without prior written permission of the Controller of HMSO. Crown copyright and may lead to prosecution or civil proceedings. TFL Licence Number : GD 1004269</div>								
				<b>Client</b>				
				<b>Transport for London</b> <b>Street Management</b> Windsor House 42-50 Victoria Street London SW1H 0TL 020 7343 5000				
<b>Title</b>				<b>Project</b>				
AS-BUILT BOUNDARY POINT LAYOUT 099				CONGESTION CHARGING SCHEME				
A501 - MARYLEBONE ROAD / SEYMOUR PLACE				WESTMINSTER AREA				
<b>Scale</b>				<b>Hyder Consulting</b>				
A3 1:500								
<b>Date</b>				<b>Hyder Consulting Limited</b>				
MARCH 2003				29 Bressenden Place				
<b>© Copyright Reserved</b>				London SW1E 5DZ				
<b>Rev</b>								
A								
<b>Dwg No.</b>								
LN40002/AB/WE/099								