


Haymarket

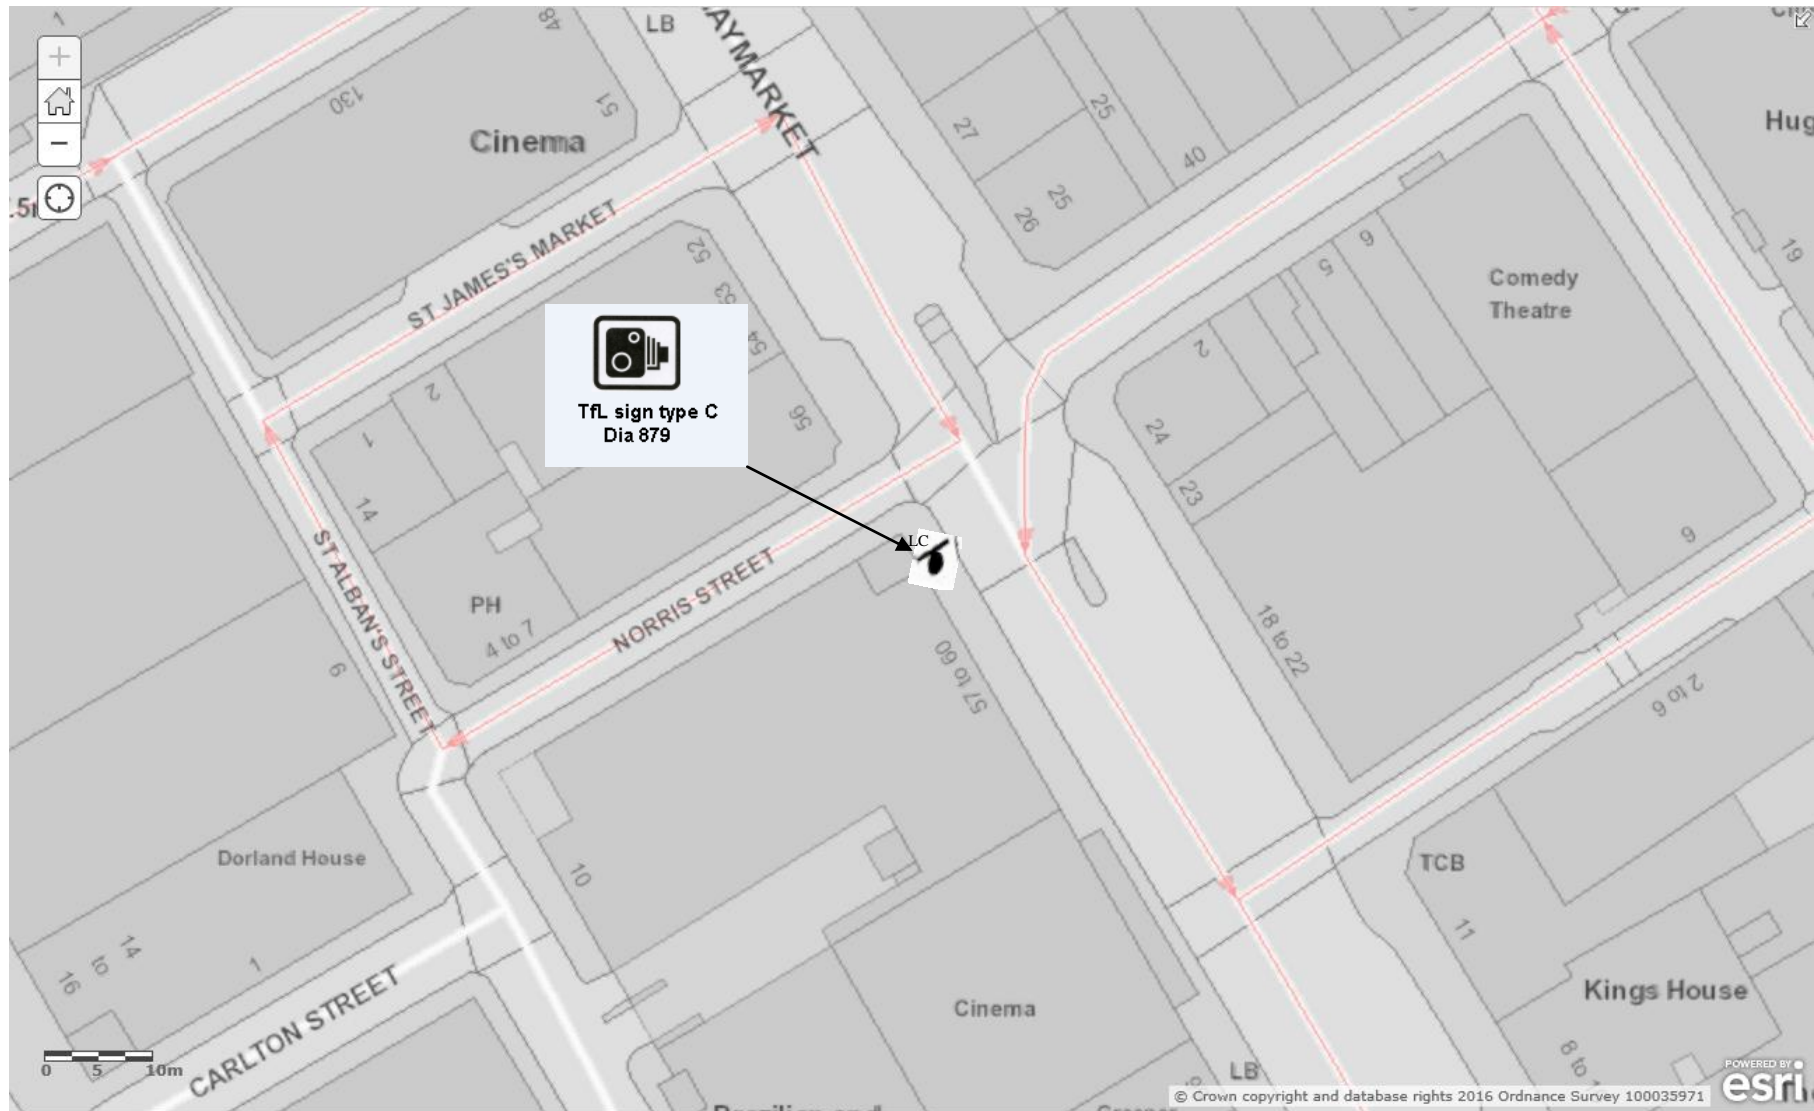

AS-BUILT

Congestion Charging Scheme

LN40002_AB_WE_081.3

Haymarket, Sbnd, 5m s of jn
with Norris St, o/s Planet
Hollywood, on LC