


Charing Cross Road

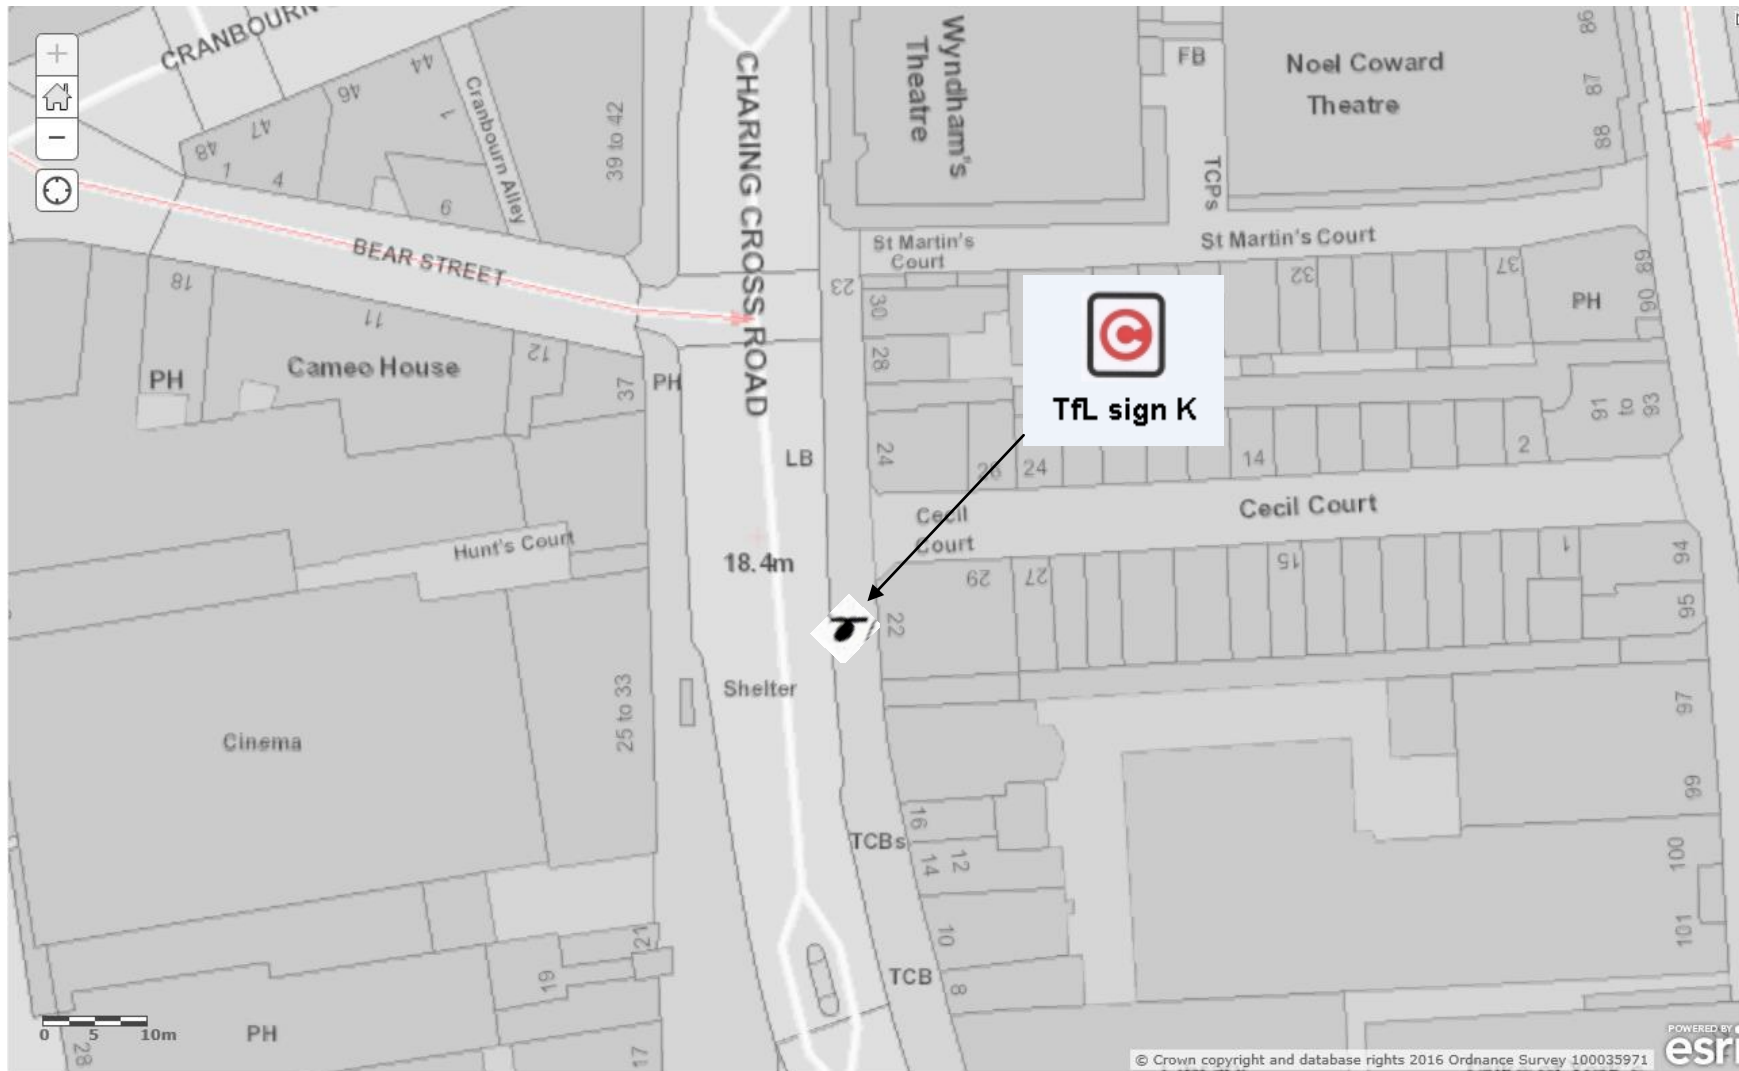

AS-BUILT

Congestion Charging Scheme

LN40002_AB_WE_081.4

Charing Cross Road, Sbd, s of jn
with St Martin's Court, o/s no.22, on
LC no. 32