


## Portland Place

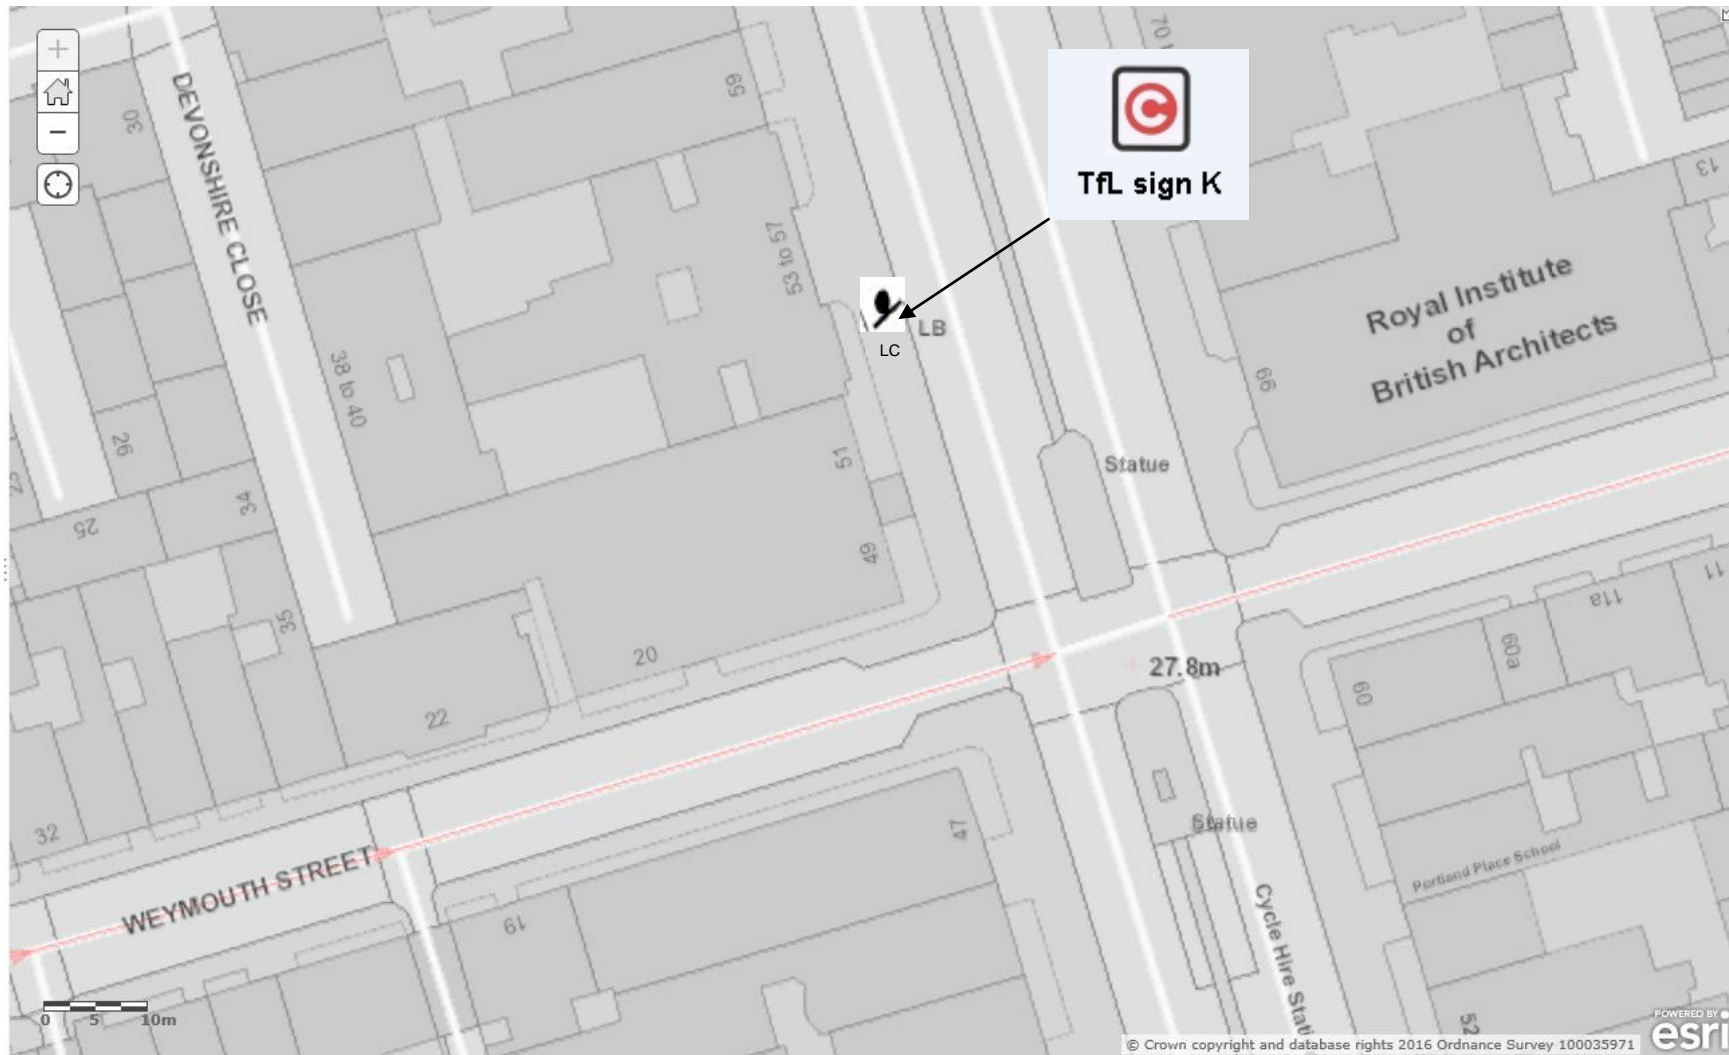

AS-BUILT

Congestion Charging Scheme

LN40002\_AB\_WE\_081.1

Portland Place Nbd, 25m n of jn  
with Weymouth St, o/s 55 Portland  
PI, on LC 8