


LEGEND:	
<input type="checkbox"/> H	EXISTING HOPPER BOX
o LC	EXISTING LAMP COLUMN
<input checked="" type="checkbox"/> TB	EXISTING TTS SIGNAL POLE
• LC	NEW LAMP COLUMN
b SP	EXISTING SIGN POST
o B	EXISTING POST BOX
o SP	NEW SIGN POST
<input type="checkbox"/> B	EXISTING BOLLARD
<input type="checkbox"/> IC	EXISTING INSPECTION CHAMBER
<input type="checkbox"/> IG	EXISTING IGP
<input type="checkbox"/> TC	EXISTING TRAFFIC CAMERA
<input type="checkbox"/> G	EXISTING GULLY
<input type="checkbox"/> SC	EXISTING SPEED CAMERA
OECP	EXISTING ENFORCEMENT CAMERA POST
REMOVE EXISTING ROADMARKINGS	
<input type="checkbox"/> NEW ROAD MARKING TYPE TFL P	TO BE LOCATED CENTRALLY IN LANE UNLESS SHOWN OTHERWISE
<input type="checkbox"/> NEW ROAD MARKING TYPE TFL O	TO BE LOCATED CENTRALLY IN LANE UNLESS SHOWN OTHERWISE
<input type="checkbox"/> PROPOSED ENFORCEMENT CAMERA (BY OTHERS)	
<input type="checkbox"/> PROPOSED CONTROL CABINET & FEEDER PILLAR (BY OTHERS)	

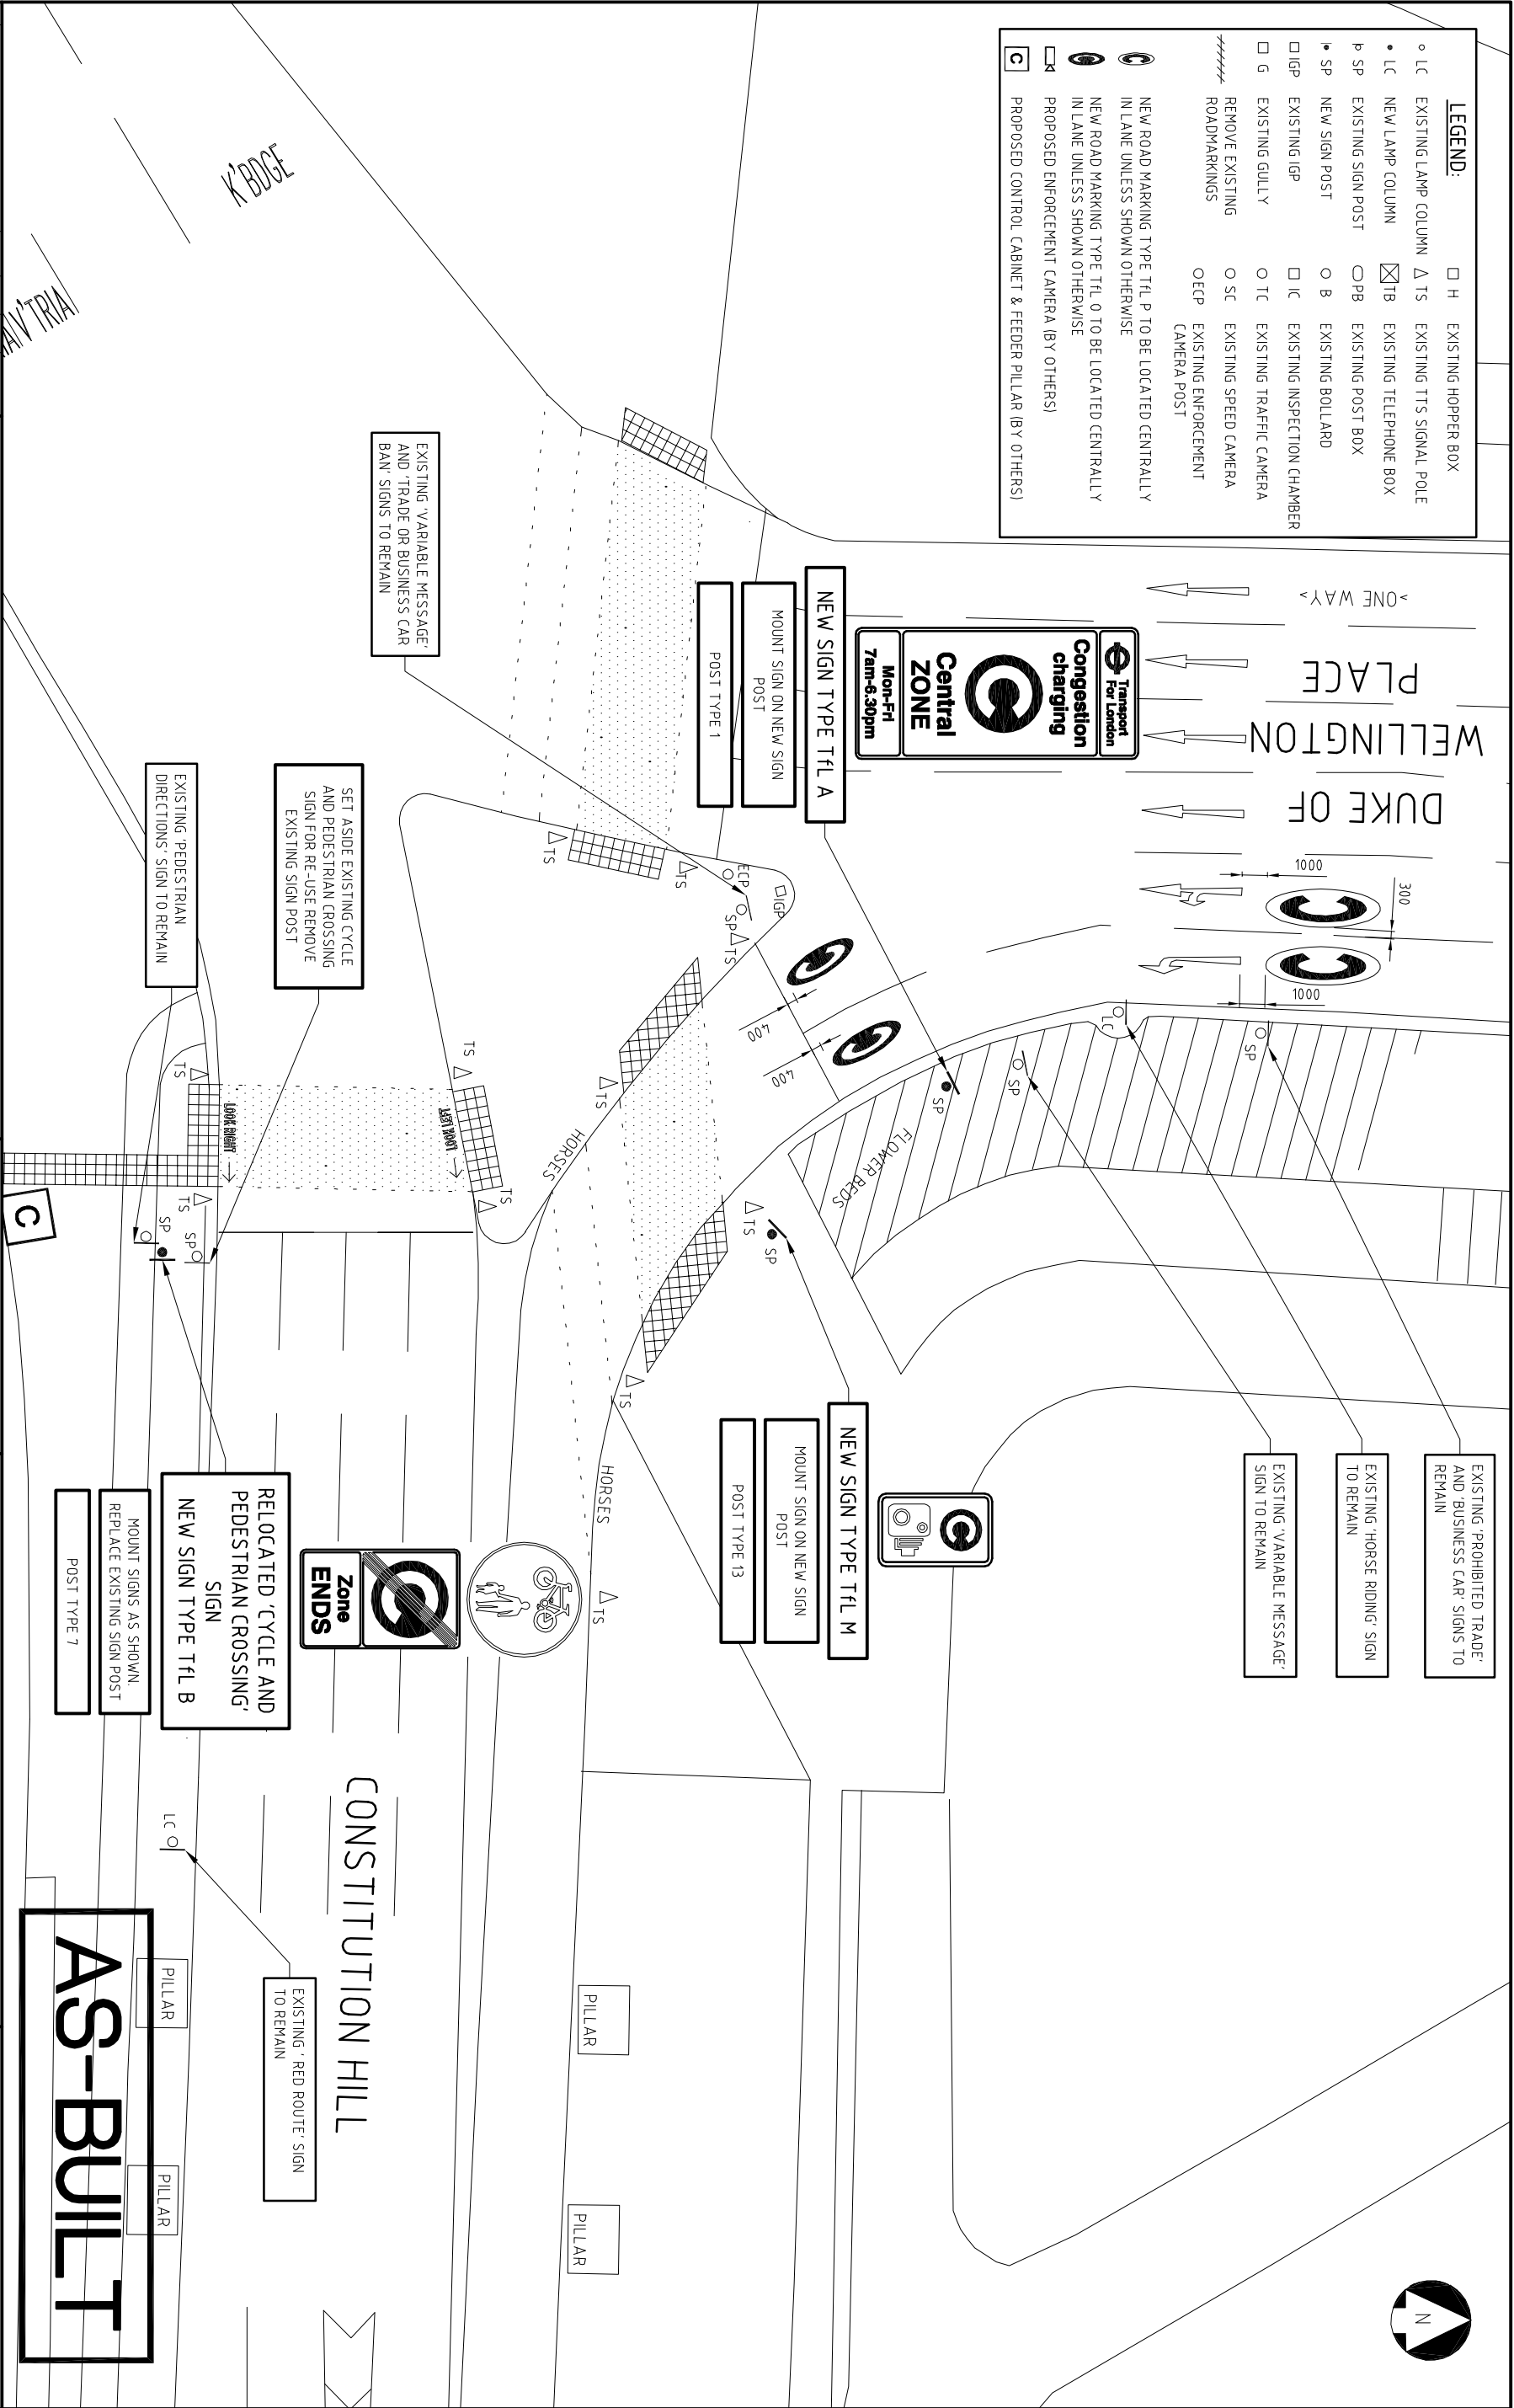

- Notes
1. ALL INSTRUCTIONS SHOWN DRAWING HAVE BEEN CARRIED OUT UNLESS NOTED OTHERWISE.
 2. ALL DIMENSIONS ARE SHOWN IN MILLIMETRES UNLESS OTHERWISE INDICATED
 3. CLEARANCE TO ALL SIGNS TO BE 450mm MIN. UNLESS SPECIFIED OTHERWISE
 4. SIGN MOUNTING HEIGHT TO BE 2m UNLESS SPECIFIED OTHERWISE

Rev	Description of Issue/Revision	Author	Chkd	Appd	Date
A	AS-BUILT	IG	RDP	GH	12/05/03
Designed	RDP	Drawn	IG	Datum	N/A

Location N:\LN40002\AS-BUILT\LN40002_AB_WE_127.DWG

Client

Transport for London
Street Management
Windsor House
42-50 Victoria Street
London SW1H 0TL
020 7343 5000

Project

CONGESTION CHARGING SCHEME
WESTMINSTER AREA

Title

AS-BUILT BOUNDARY POINT LAYOUT 127
DUKE OF WELLINGTON PLACE / CONSTITUTION HILL

Scale

A3 1:250

Date

MARCH 2003

Hyder Consulting Limited
29 Breckenridge Place
London SW1E 5DZ

Drwg. No.

LN40002/AB/WE/127

Rev

A