


For sign details refer to drawing
STPJ274-TFL-120-26_DS011-DRG-TR-00002

For boundary sign location refer to drawing No:
STPJ274-TFL-003-26_01-DRG-TR-00005




For sign details refer to drawing
STPJ274-TFL-120-26_DS010-DRG-TR-00002

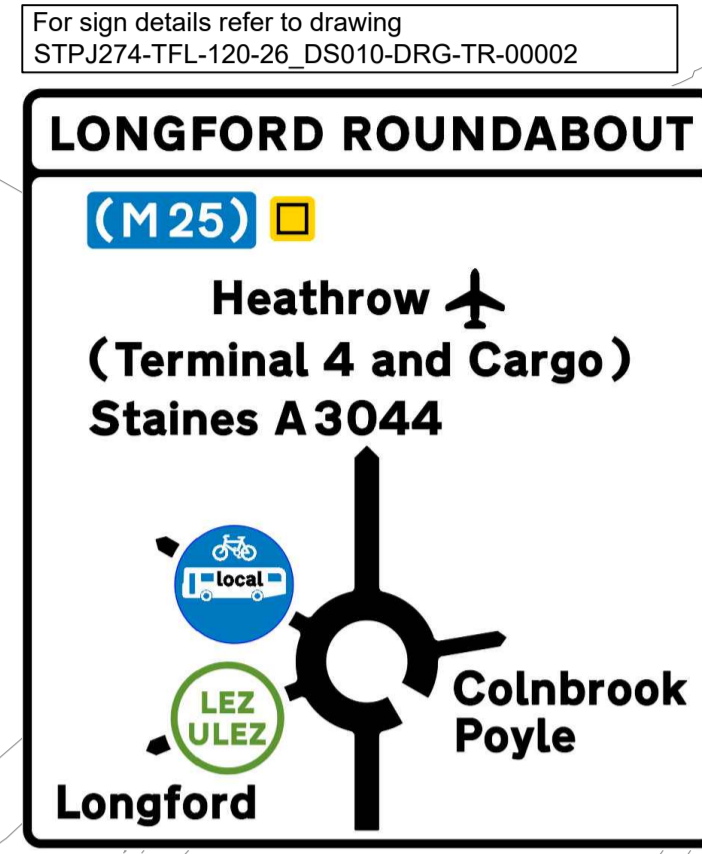

Sign: HDBR002
x-height: 50mm
Width: 410mm Height: 695mm
Area: 0.28m² Mount. Ht.: 2400mm
Material: Class RA2 (12899-1:2007)
For Sign details refer to drawing
STPJ274-TFL-120-ZZ_XX-DRG-TR-00005

For boundary sign location refer to drawing No:
STPJ274-TFL-003-26_01-DRG-TR-00003

For boundary sign location refer to drawing No:
STPJ274-TFL-003-26_01-DRG-TR-00002

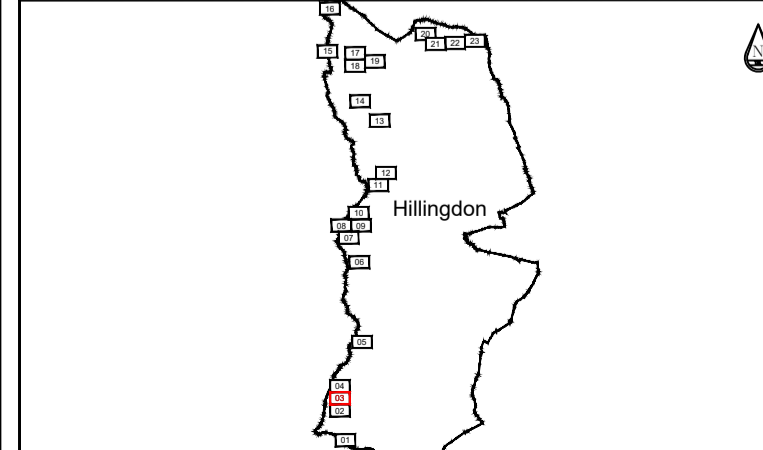

LEGEND	
SP	Existing sign and post
LC	Existing lamp column and sign plate
SP	Proposed sign and post
SP	Proposed sign on existing post
SP	Proposed sign on existing lamp column
SP	Proposed sign offset on new post
SP	Proposed sign offset on existing post
SP	Proposed sign offset on existing lamp column
SP	Proposed sign on ULEZ camera post
SP	ULEZ camera post
SP	Sign and post to be removed/relocated
SP	Sign plate to be removed/relocated from sign post
LC	Sign plate to be removed/relocated from lamp column
SP	TLRN Boundary
SP	LEZ/ULEZ Boundary

- NOTES**
- This drawing to be read in conjunction with all other referenced drawings.
 - All dimensions in metres, unless otherwise stated.
 - All signs to have a minimum horizontal clearance of 450mm from face of carriageway kerb where speed of road is up to 30mph or 650mm where speed of road is 40mph or above.
 - All signs to be mounted at a minimum height of 2.4m, unless otherwise stated.
 - Paving to be reinstated to match existing following installation of new posts.

TFL RESTRICTED	201	NOV 23	As built	AJ	ILC	CAH
	rev	date	details	dm	chk	app
	As built ADS & Boundary IZR Location Plan					
	Project London Wide ULEZ Expansion 2023 Originator Transport for London Asset Classification General Arrangement Location London Borough of Hillingdon Scale 1:1000 @ A1 Sheet no 3 of 23					

submittal
AB AS BUILT
revision
Z01
drawing No
STPJ274-TFL-010-26_01-DRG-TR-00003
© Crown copyright and database rights 2023 Ordnance Survey 100039871