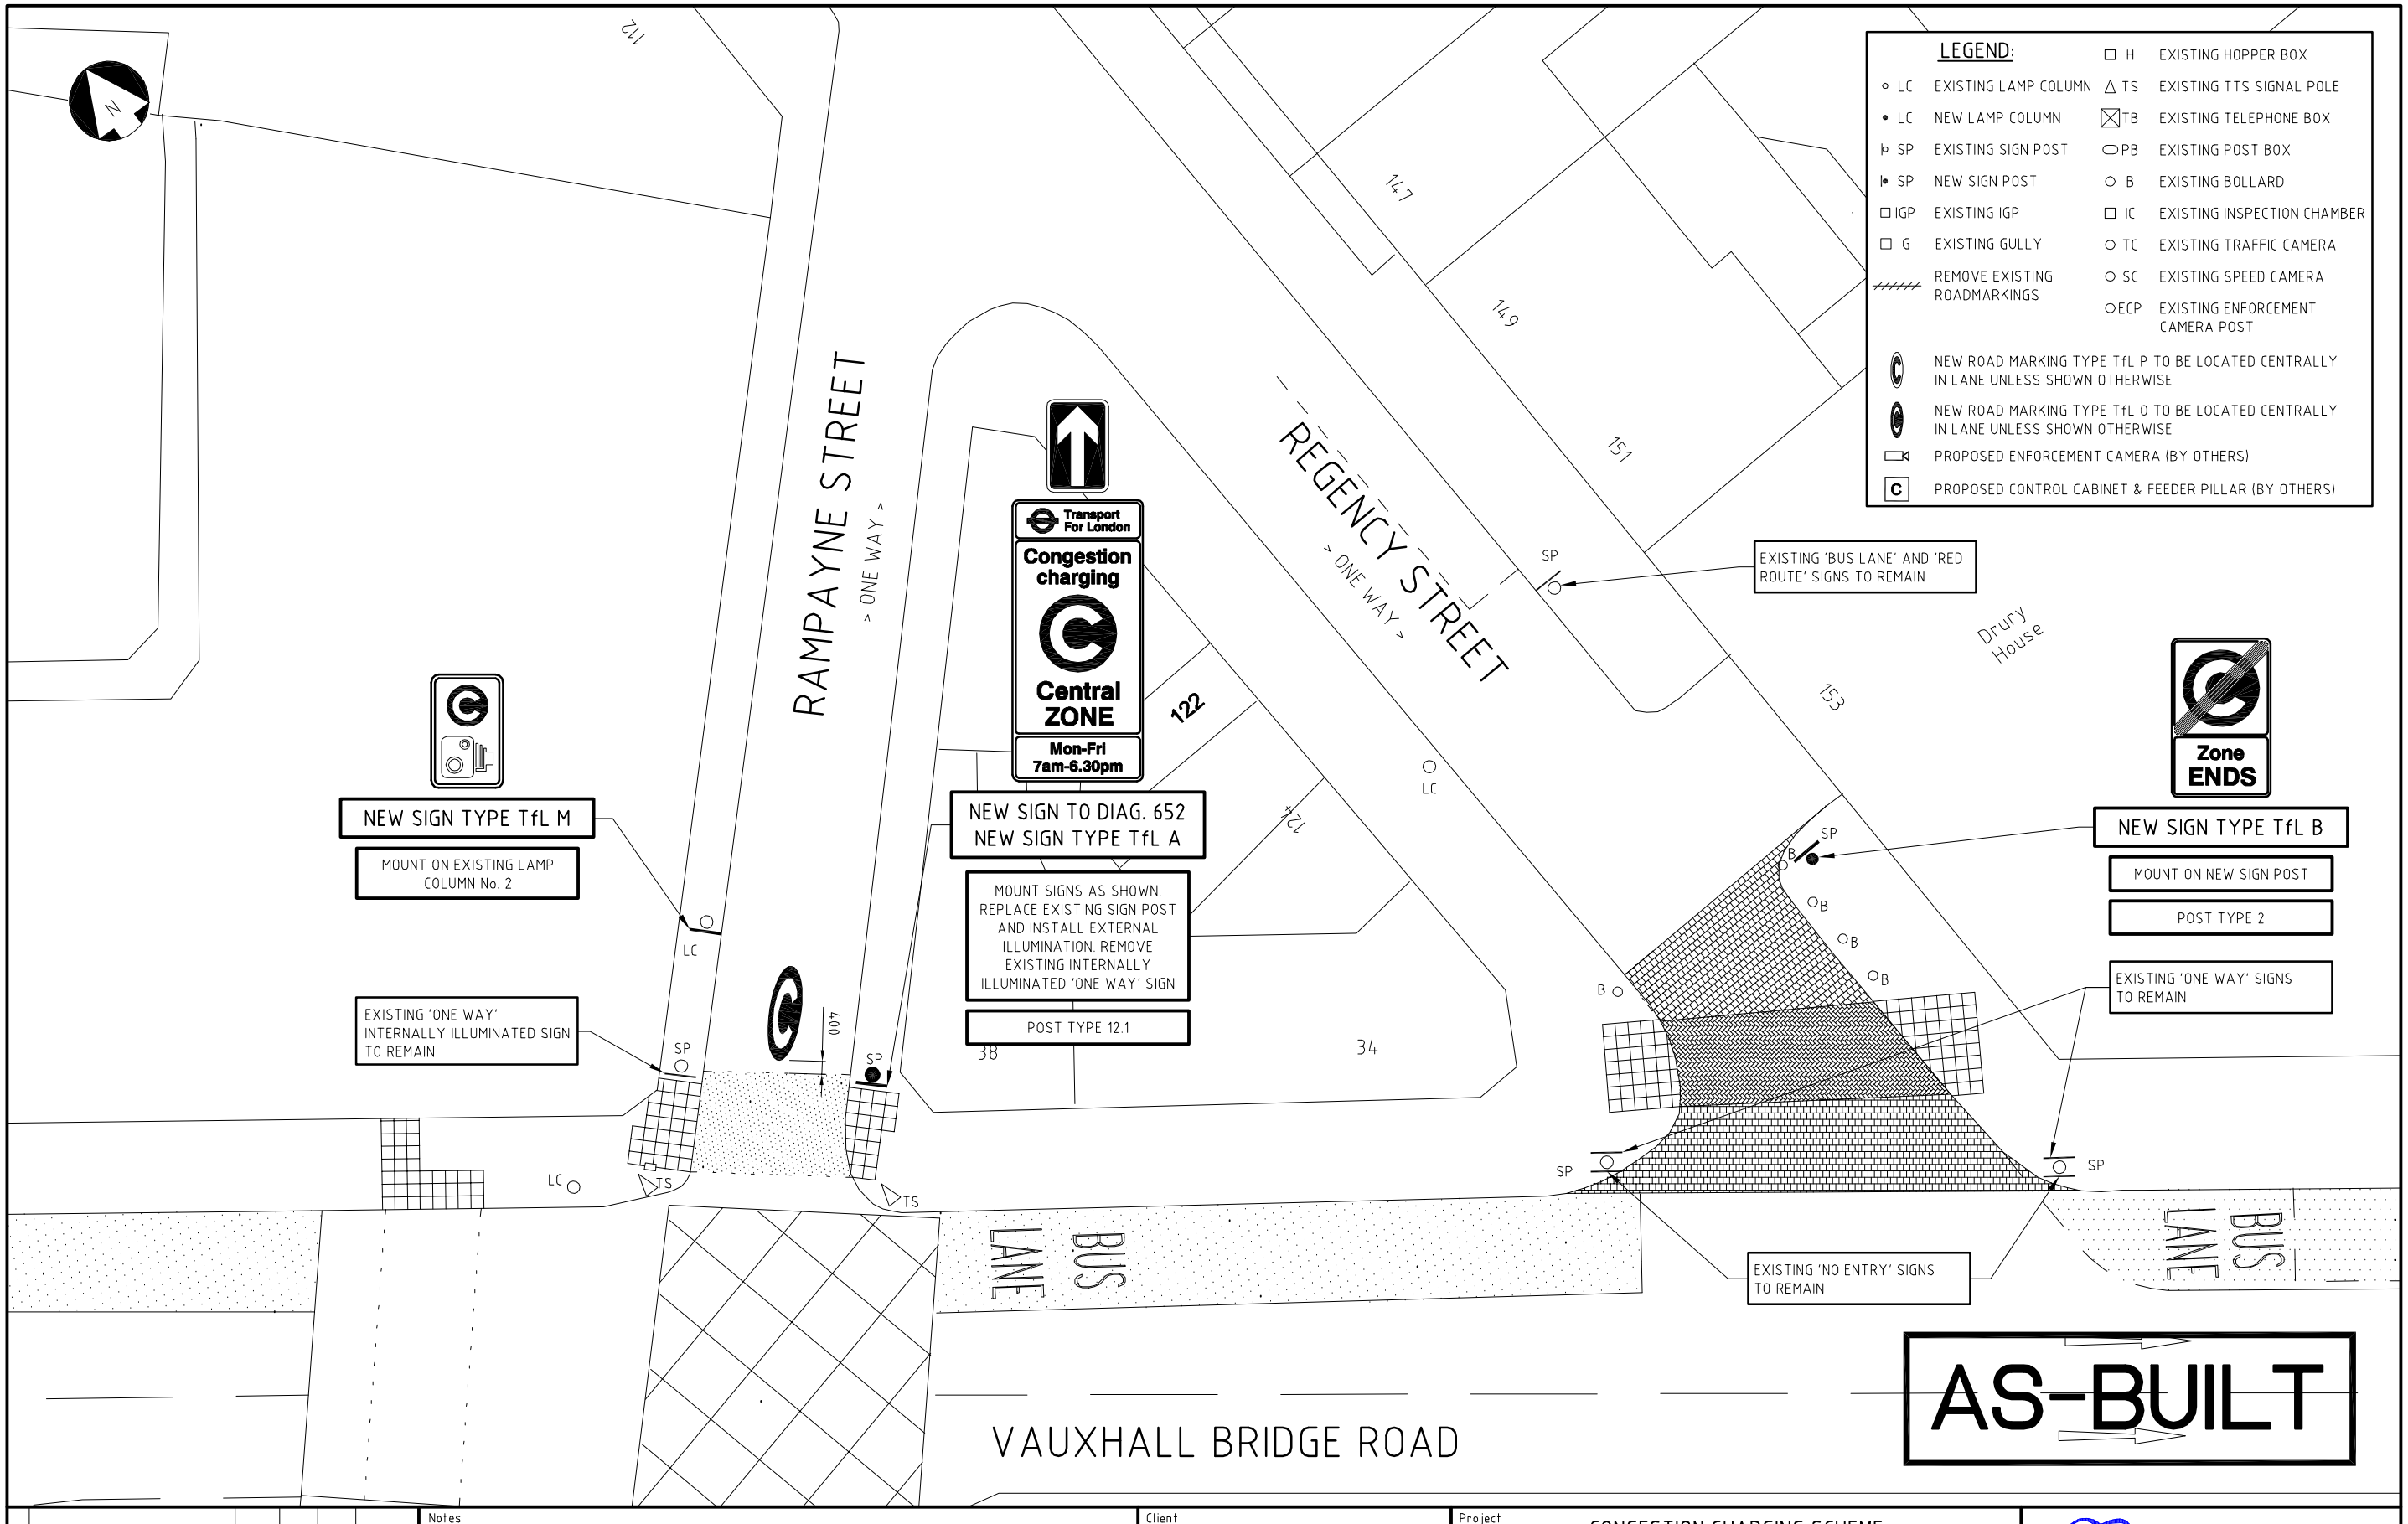

Rev	Description of Issue/Revision	Author	Chkd.	Appd	Date
A	AS-BUILT	IG	RDP	GH	12/05/03

Designed RDP | Drawn IG | Datum N/A

Location N:\LN40002\AS-BUILT\LN40002_AB_WE_141-142.DWG

Notes
1. ALL INSTRUCTIONS SHOWN DRAWING HAVE BEEN CARRIED OUT UNLESS NOTED OTHERWISE.
2. ALL DIMENSIONS ARE SHOWN IN MILLIMETRES UNLESS OTHERWISE INDICATED
3. CLEARANCE TO ALL SIGNS TO BE 450mm MIN. UNLESS SPECIFIED OTHERWISE
4. SIGN MOUNTING HEIGHT TO BE 2.1m UNLESS SPECIFIED OTHERWISE

Reproduced from/based upon the Ordnance Survey's 1:1250 maps with the permission of the Controller of HMSO. © Crown Copyright, Unauthorised reproduction infringes Crown copyright and may lead to prosecution or civil proceedings. TfL Licence Number : GD 030426

Client
Transport for London Street Management
Windsor House
42-50 Victoria Street
London SW1H 0TL
020 7343 5000

Project
CONGESTION CHARGING SCHEME
WESTMINSTER AREA

Title
AS-BUILT BOUNDARY POINT LAYOUT 141-142
A202 VAUXHALL BRIDGE ROAD / RAMPAYNE STREET
A202 VAUXHALL BRIDGE ROAD / REGENCY STREET

Hyder Consulting Limited
29 Bressenden Place
London SW1E 5DZ

Scale A3 1:200
Date MARCH 2003
© Copyright Reserved
Drg. No. LN40002/AB/WE/141-142
Rev A