D.M. 19963.
D.M. 20114.
D.M. 20649
D.M. 24663

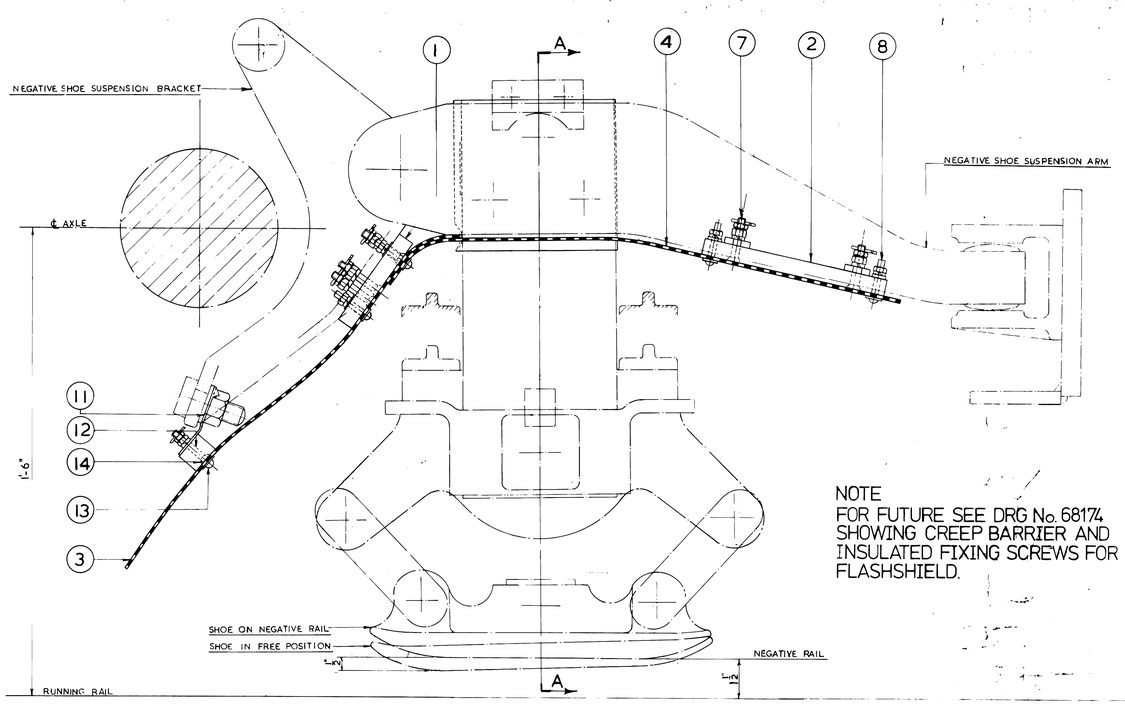

NOTE
FOR FUTURE SEE DRG No. 68174 SHOWING CREEP BARRIER AND INSULATED FIXING SCREWS FOR FLASHSHIELD.

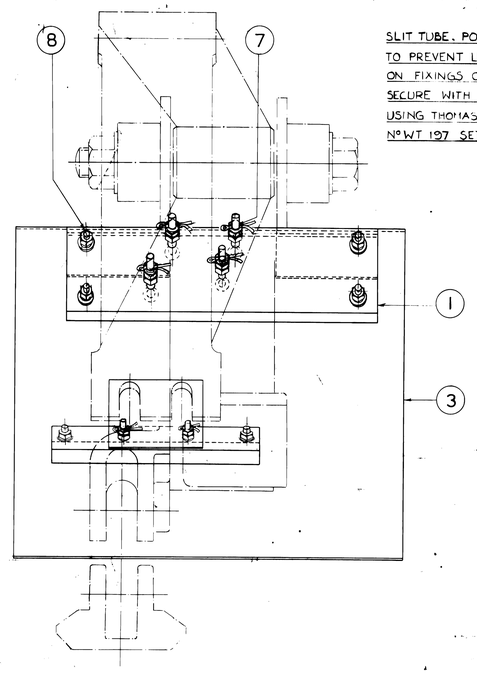

SLIT TUBE. POSITION AS SHOWN TO PREVENT LEAD CHAFING ON FIXINGS OR SHIELD & SECURE WITH TIES APPLIED USING THOMAS & BETTS TOOL No WT 197 SET TO POSN 5.

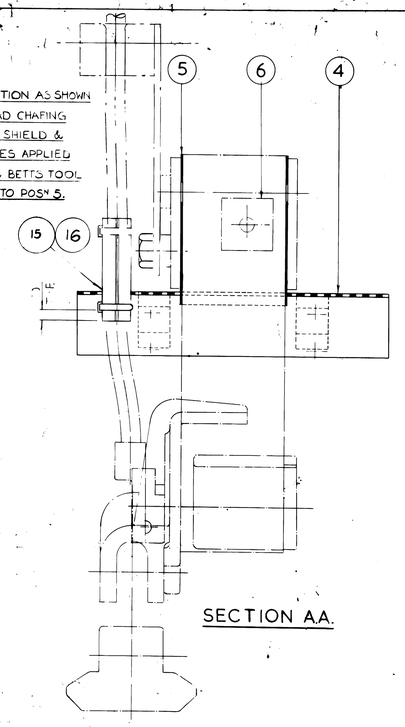

SECTION A.A.

RUNNING RAIL

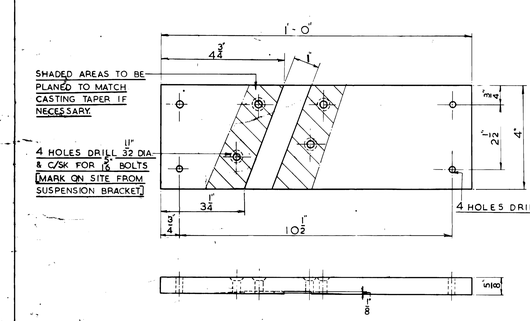

1

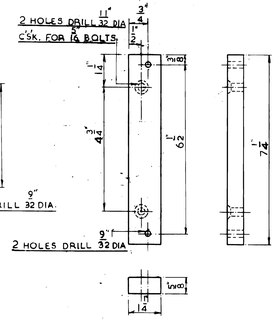

2

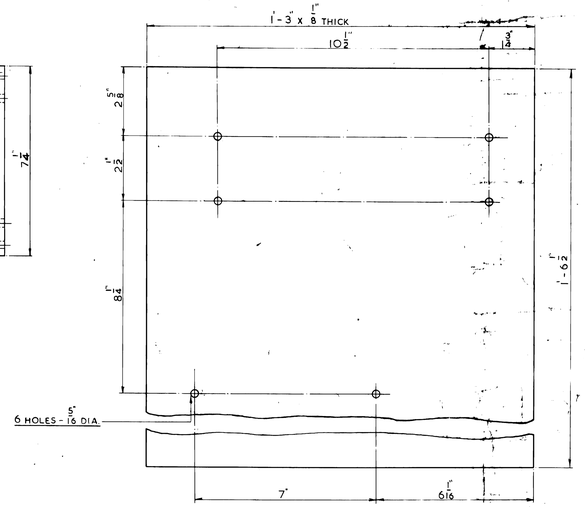

3

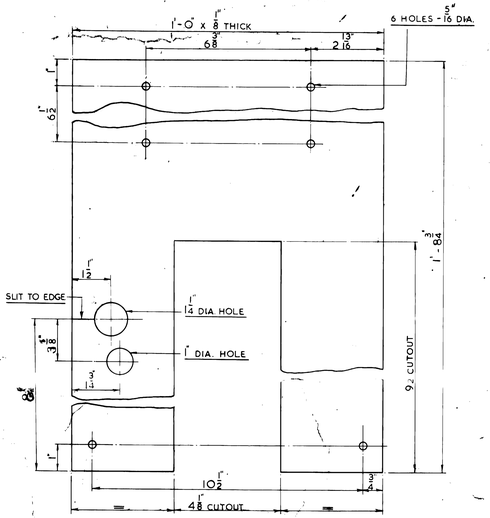

4

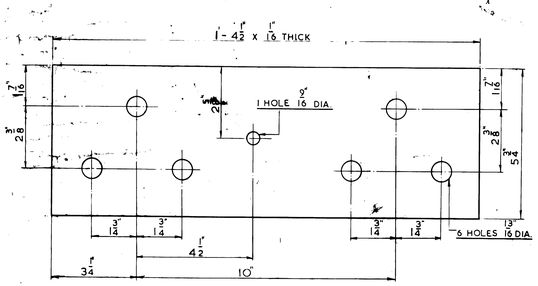

5

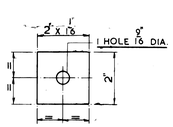

6

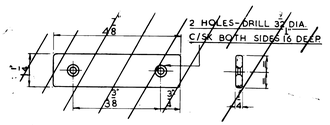

10

ITEMS 1,2,3 & 12 TO BE GIVEN 2 COATS OF OILPROOF ANTI-TRACKING GREY ENAMEL No. 1172L.

ITEM	DESCRIPTION	MATERIAL	DRG No.	No. PER SET	No. IN STOCK LIST No.	REMARKS
15	CABLE TIE 7/8 I.D. x 1/8 W.T. x 4" LONG	NYLON NATURAL RUBBER		2		THOMAS & BETTS TY272M
14	1/4 B.S.W. SCREW 1/2 LONG C/SK. HD.	M.S.		1		BRISCH No 1071-116
13	1/4 " " 1 1/4 " RND. "			2		WITH NYLOC NUT, 2 PLAIN WASHERS & 1 GROVER WASHER
12	SUPPORT BLOCK	HARDWOOD	43554/13	1		
11	" PLATE	M.S.	43554/12	1		
~~10~~	~~STIFFENER~~	~~HARDWOOD OR PLYWOOD~~		~~1~~	499/815	
9	PACE	LEATHER	43491/10	1		
8	1/4 B.S.W. SCREW 1/2 LONG RND. HD	M.S.		8		WITH NYLOC NUT, 2 PLAIN WASHERS & 1 GROVER WASHER
7	" " 1 1/2 " C/SK. "	"		8		
6	INSULATING WASHER	LEATHEROID		1	648/2281	EXISTING ITEM
5	BEAM INSULATION	"		1	818/812	
4	FLASH SHIELD [AT ARM]	KLINGERIT *		1	514/1864	* STYLE 40
3	" " [" BKT.]	" *		1	514/1863	" 40
2	MOUNTING BLOCK [" ARM]	HARDWOOD		2	58/2285	EXISTING ITEM
1	" " [" BKT.]	"		1	58/2284	

DRAWN A.E.S.
TRACED G.A.P. & P.H.
CHECKED
APPROVED
DRAWER No. [redacted]/156

FLASH SHIELD FOR NEGATIVE SHOE GEAR.

A.60. & A.62. STOCK.

H THIS PART, DATSON, BONNERS & PARTS LIST FOR TESTS PRELIMINARY TO INSTALL NUT & WASHER ADDED TO SCREW
G REDRAWN FOR ISSUE
F
E
D
C
B
A

(M) E. T. BY
(M) C.M.E. OFFICE
DRAWING No.
43535

MICROFILMED

Transport for London
London Underground
MAYOR OF LONDON
UNCONTROLLED COPY
WILL NOT BE UPDATED
THIS DRAWING MAY NOT BE CURRENT AND SUBJECT TO AMENDMENT. THEREFORE DO NOT PROCURE OR MANUFACTURE ANY PART THEREOF WITHOUT FIRST SEEKING VERIFICATION FROM THE RISE - ERM BEFORE USE