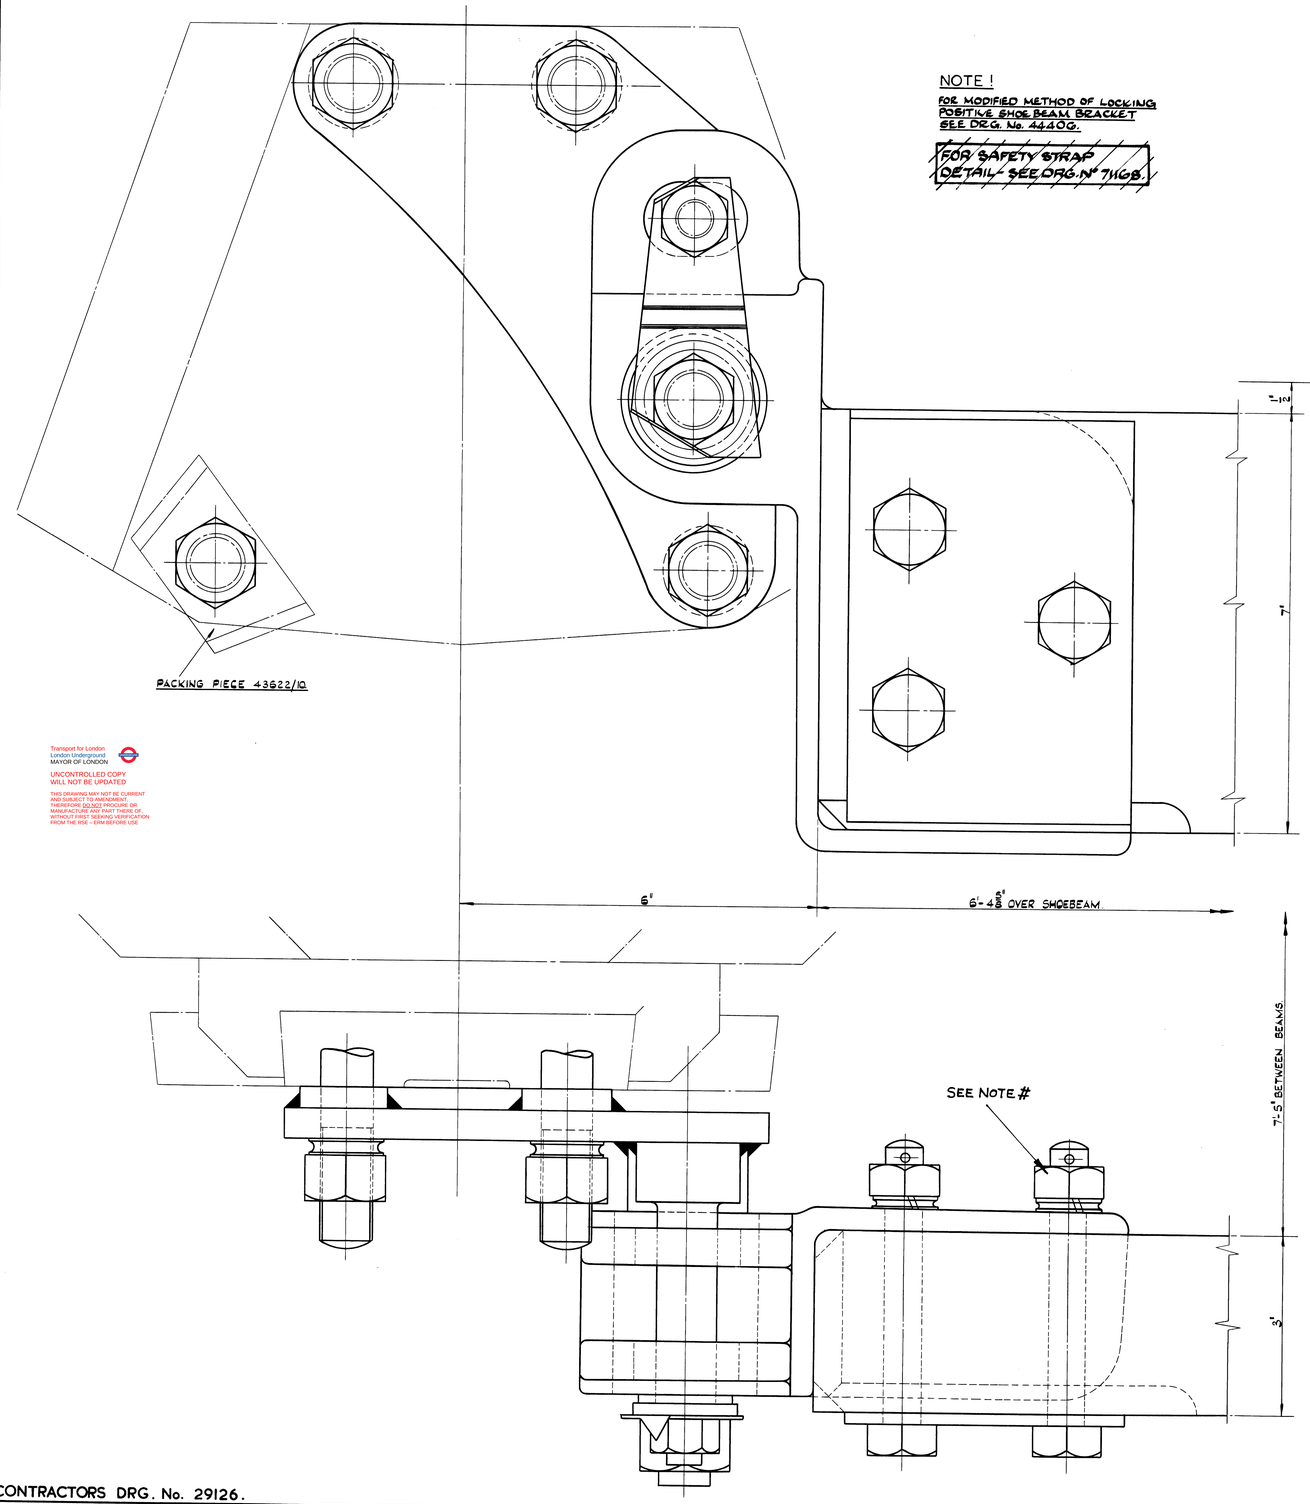

NOTE !

FOR MODIFIED METHOD OF LOCKING POSITIVE SHOE BEAM BRACKET SEE DRG. No. 44400.

~~FOR SAFETY STRAP DETAIL - SEE DRG. Nº 71168.~~

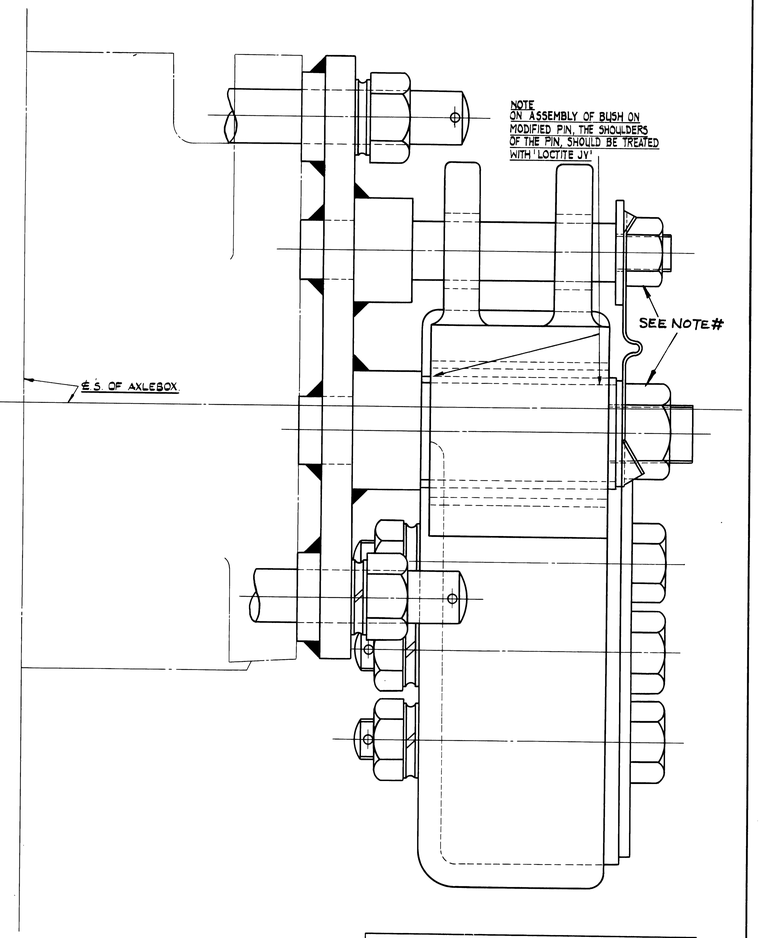

NOTE
ON ASSEMBLY OF BUSH ON MODIFIED PIN, THE SHOULDERS OF THE PIN, SHOULD BE TREATED WITH 'LOCTITE JV'

NOTE #
FOR TORQUE SETTING VALUES REFER TO TORQUE REFERENCE CHART DRG. 86930

NOTE :-

FOR DETAILS OF SHOEBEAM FIXING (OUTER AXLE) SEE DRG. No. 43622
" " " " " (INNER AXLE) " " " 43592
" ARRANGEMENT OF " " " " " " " 43590

~~FOR ARRANGEMENT OF SAFETY STRAP (OUTER AXLE) SEE DRG. Nº 71169.~~

Transport for London
London Underground
MAYOR OF LONDON
UNCONTROLLED COPY
WILL NOT BE UPDATED
THIS DRAWING MAY NOT BE CURRENT AND SUBJECT TO AMENDMENT; THEREFORE DO NOT PROCURE OR MANUFACTURE ANY PART THERE OF, WITHOUT FIRST SEEKING VERIFICATION FROM THE RSE – ERM BEFORE USE

Transport for London
London Underground
MAYOR OF LONDON
UNCONTROLLED COPY
WILL NOT BE UPDATED
THIS DRAWING MAY NOT BE CURRENT AND SUBJECT TO AMENDMENT; THEREFORE DO NOT PROCURE OR MANUFACTURE ANY PART THERE OF, WITHOUT FIRST SEEKING VERIFICATION FROM THE RSE – ERM BEFORE USE

D	MET CRS 2001-1. NOTE # ADDED.	A.S.D. 6-12-83 (M)
C	SAFETY STRAP REFERENCE, DRG. No. CROSSED OUT. MOD 12115 DIN 2819	(M) SH 16/9/73
(M) B	SAFETY STRAP REFERENCE DRG. Nº ADDED. MOD. 11168: DIN 1589	EGS:- 10-1-50
A	MOD 7896 NOTE ADDED RE APPLYING 'LOCTITE' TO PIN.	P.J.E 4.1.73.

A.62 SURFACE STOCK.

ARRANGEMENT OF SHOEBEAM FIXING OUTER AXLE.

SCALE. FULL SIZE.

LONDON TRANSPORT EXECUTIVE
CHIEF MECHL. ENGINEERS OFFICE.

DRG. No. 43623.

DATE. 5. 12. 62.

MICROFILMED

D C B A

OFFICE. 407 FILING. 407

CONTRACTORS DRG. No. 29126.